69-1

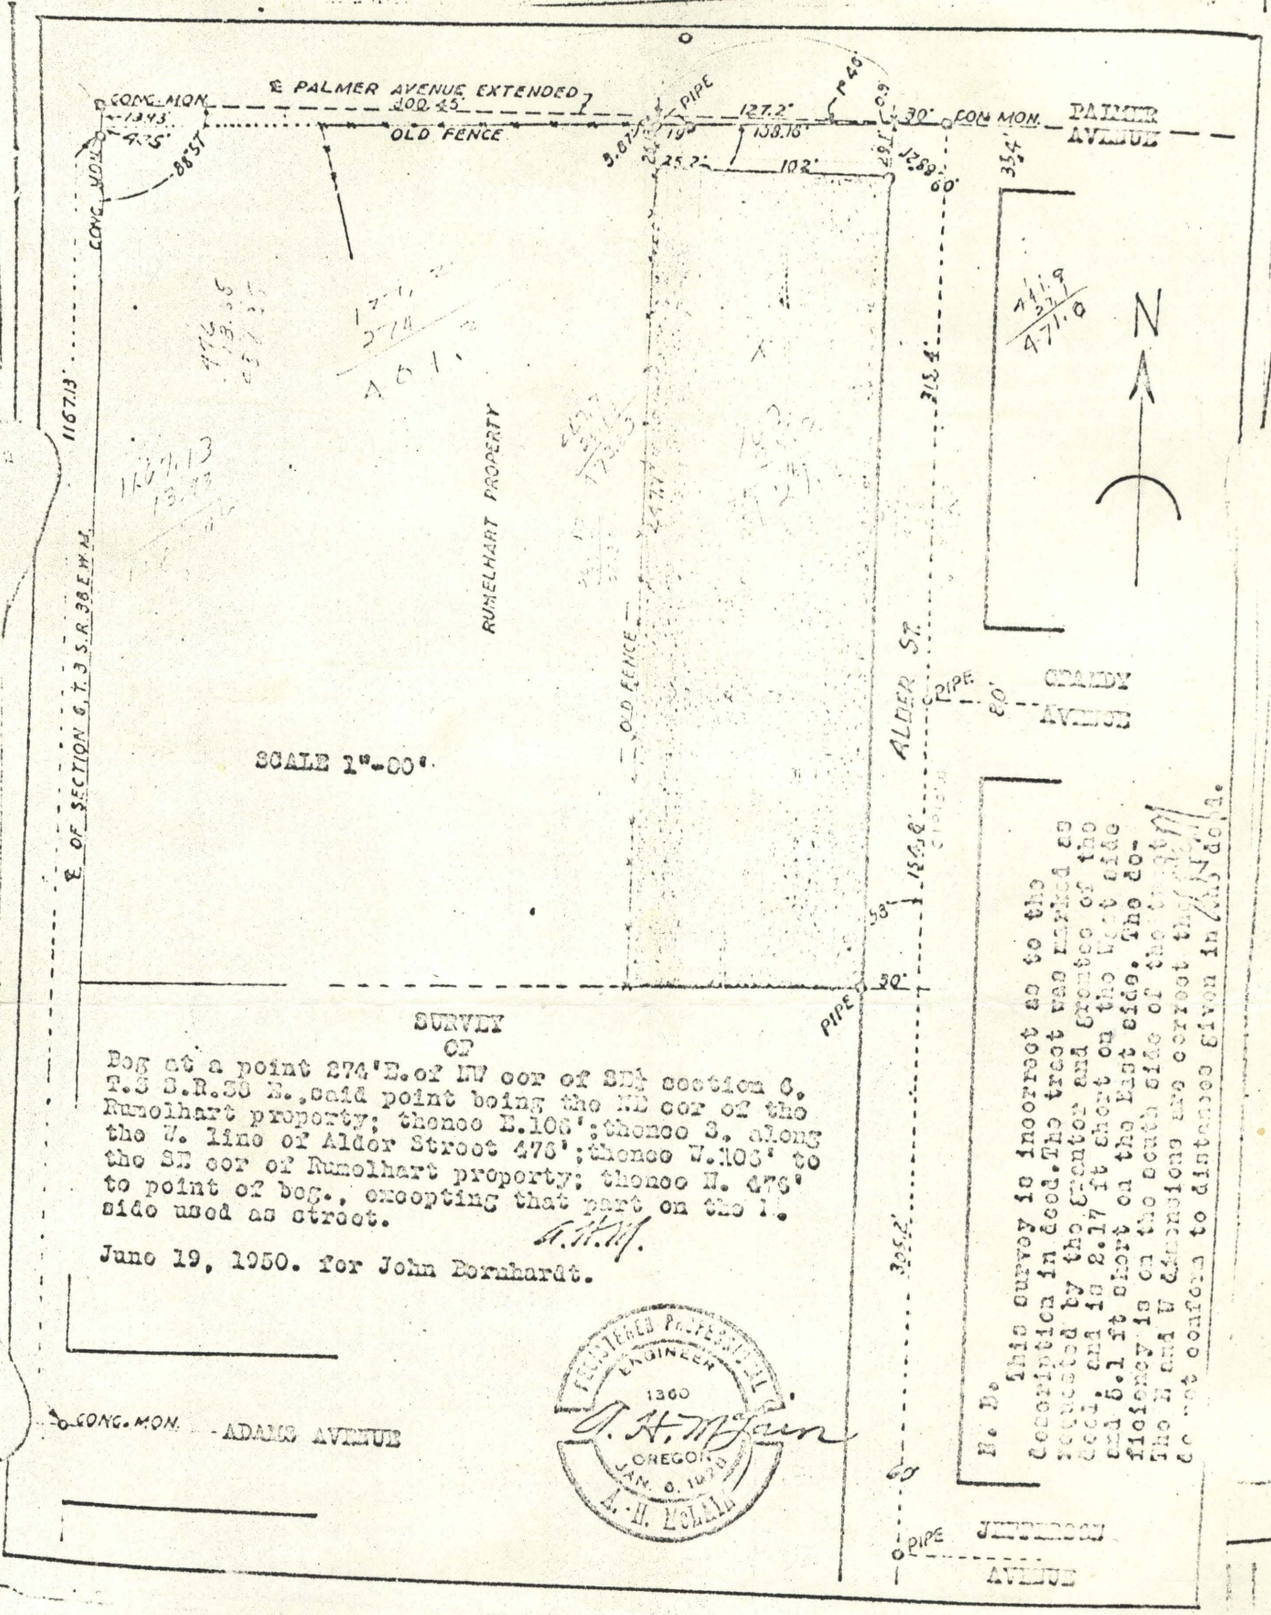

SURVEY
OF

Beg at a point 274'E. of NW cor of SW¼ section 6, T.3 S.R.3E W.M. said point being the NE cor of the Rumelhart property; thence E.108'; thence S. along the W. line of Alder Street 476'; thence W.108' to the SE cor of Rumelhart property; thence N. 476' to point of beg., excepting that part on the E. side used as street.

June 19, 1950. for John Bornhardt.

REGISTERED PROFESSIONAL ENGINEER 1360 OREGON JAN. 6, 1933 A. H. McLAIN

N. B.
This survey is incorrect as to the description in deed. The tract was platted as described by the Grantor and Grantee of the deed, and is 2.17 ft short on the West side and 6.1 ft short on the East side. The deficiency is on the south side of the tract. The N. and W. dimensions are correct the [illegible] do not conform to distances given in [illegible] deed.

1-69

1-69