C Hawes

5-69

Marjoria A Nicosen
Cove ,Oregon

Date July 15, 1967

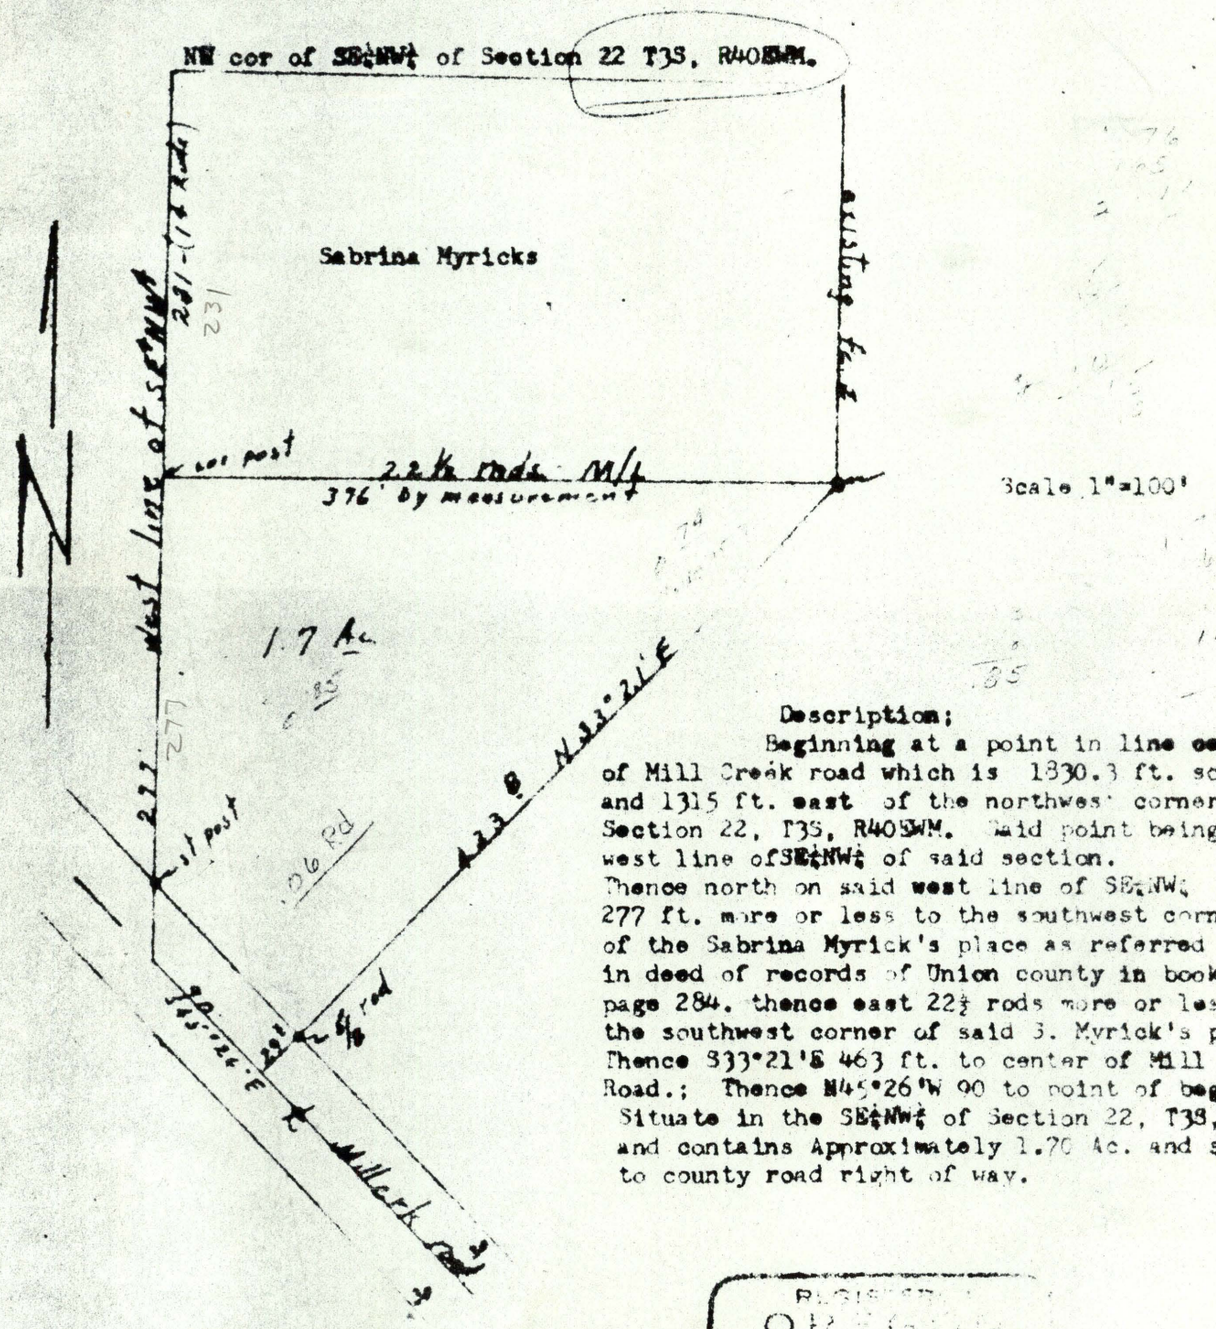

Description;

Beginning at a point in line center of Mill Creek road which is 1830.3 ft. south and 1315 ft. east of the northwest corner of Section 22, T3S, R40EWM. Said point being on the west line of SE¼NW¼ of said section.
Thence north on said west line of SE¼NW¼ 277 ft. more or less to the southwest corner of the Sabrina Myrick's place as referred to in deed of records of Union county in book 61 at page 284. thence east 22½ rods more or less to the southwest corner of said S. Myrick's place. Thence S33°21'E 463 ft. to center of Mill Creek Road.; Thence N45°26'W 90 to point of beginning. Situate in the SE¼NW¼ of Section 22, T3S, R40EWM and contains Approximately 1.70 Ac. and subject to county road right of way.

REGISTERED
OREGON
LAND SURVEYOR
James G Vogt
MAR 4, 1968
JAMES G VOGT
381

5-69

5-69