


7-69

Ken Presler  
103 1/2 Greenwood  
La Grande, Oregon

July 18, 1968


Coggans Add &  
Part of Blk 109 Chaplins

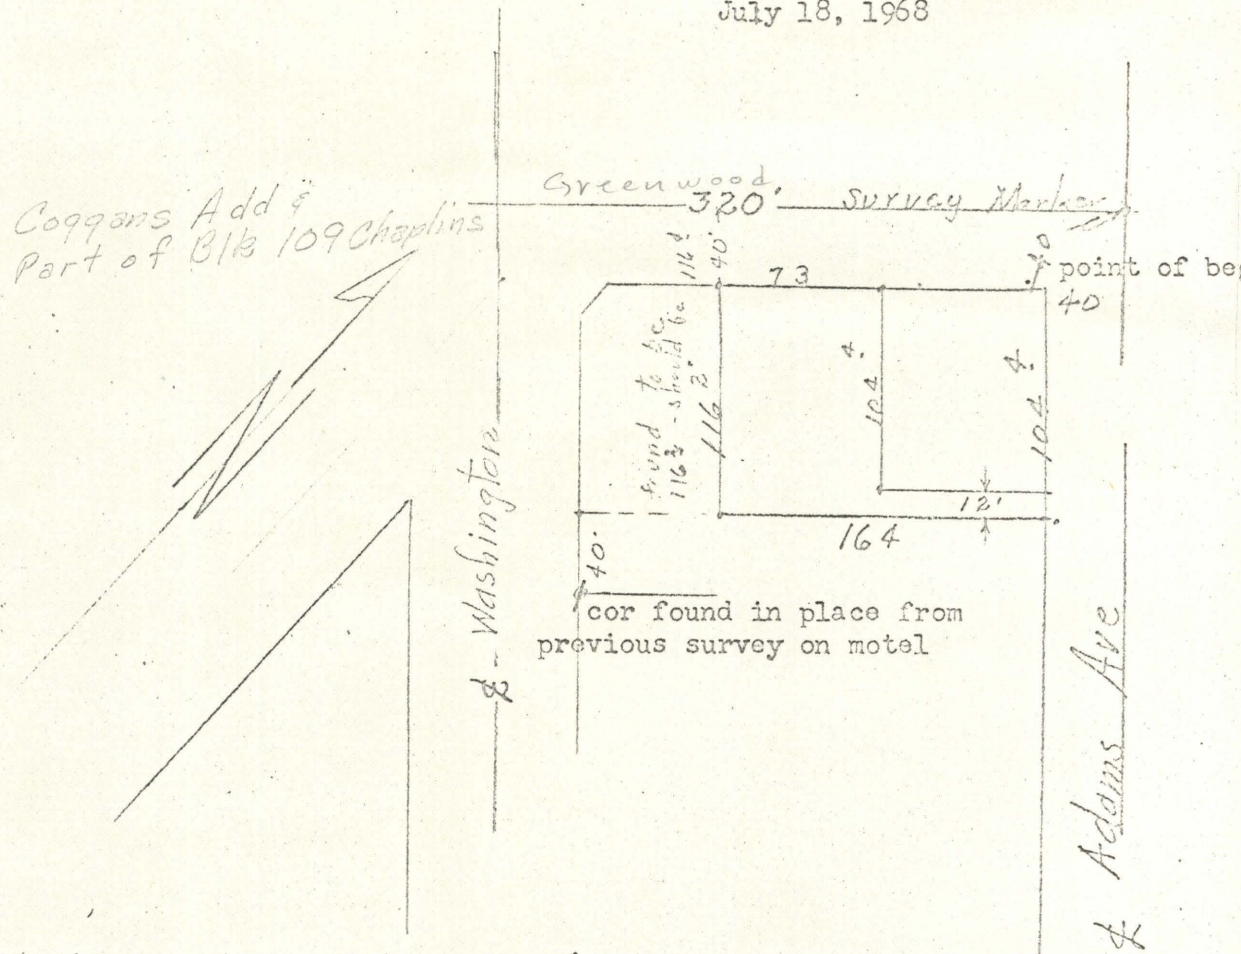

Description;

Beginning at a point on the south line of Adams Ave. 104.4 ft. southeast of the most northerly corner of Block 109 of Chaplin's Addition; thence southeast 12 ft. along Adams Ave.; thence southwest 164 ft at right angles (note; to fit points set by previous survey this is not right angle, being 90°09') thence northwest 116.4 ft. to Greenwood Street. thence northeast 73 feet; thence 104.4 ft southeast parallel to Adams Ave. thence northeast to point of beginning.

3 38 88A 6700

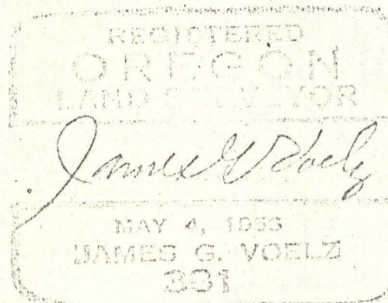

7-69

7-69