


Lynden Topping
1516--U-- Ave.
La Grande, Oregon

June 12, 1968

Description; Lot 6 of Block 3 of Sugar Addition to La Grande, Oregon.

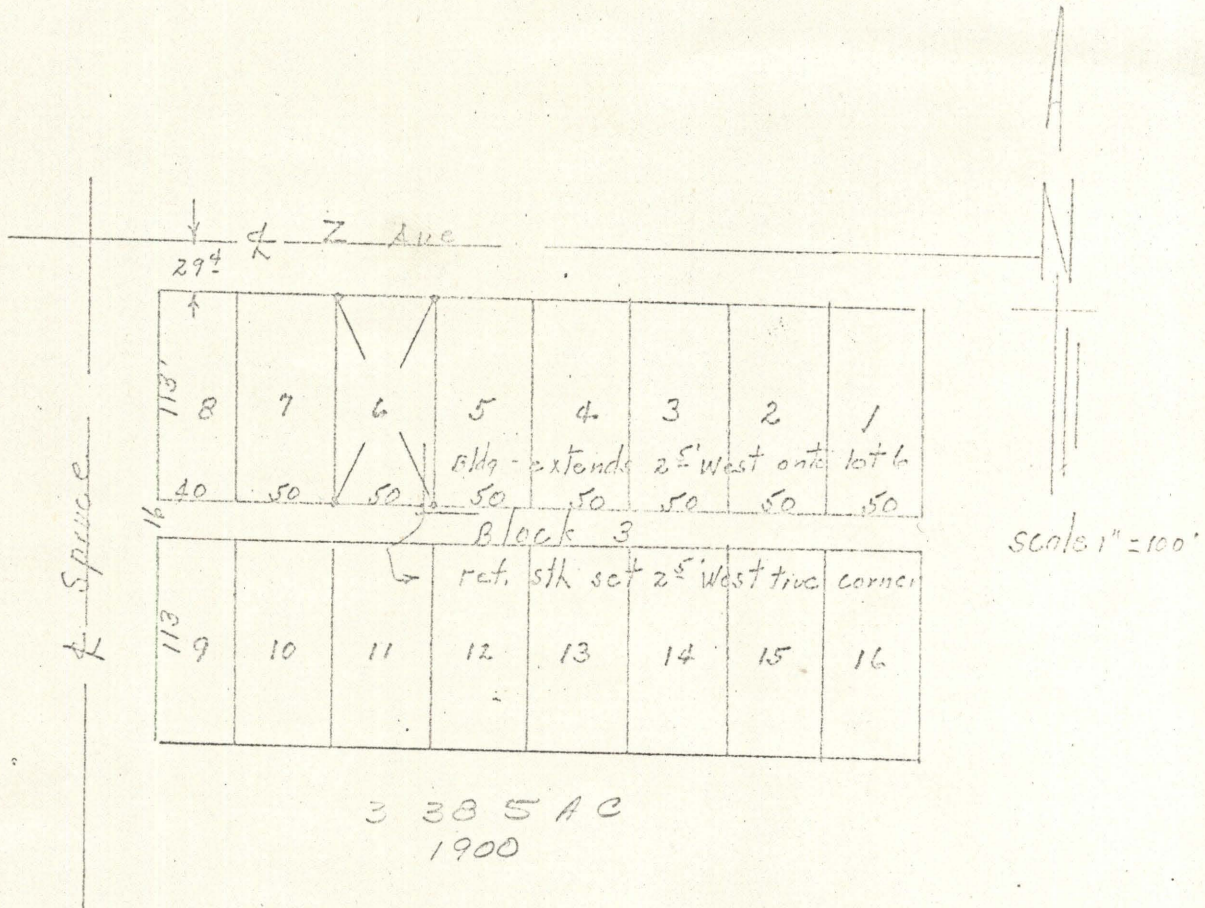

REGISTERED
OREGON
LAND SURVEYOR
James G. Vorlez
MAY 4, 1968
JAMES G. VORLEZ
381

9-69

9-69