
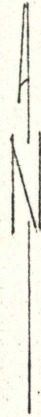


69-51

2

Church of God
2005 Cedar St.
La Grande, Oregon

July 28, 1968

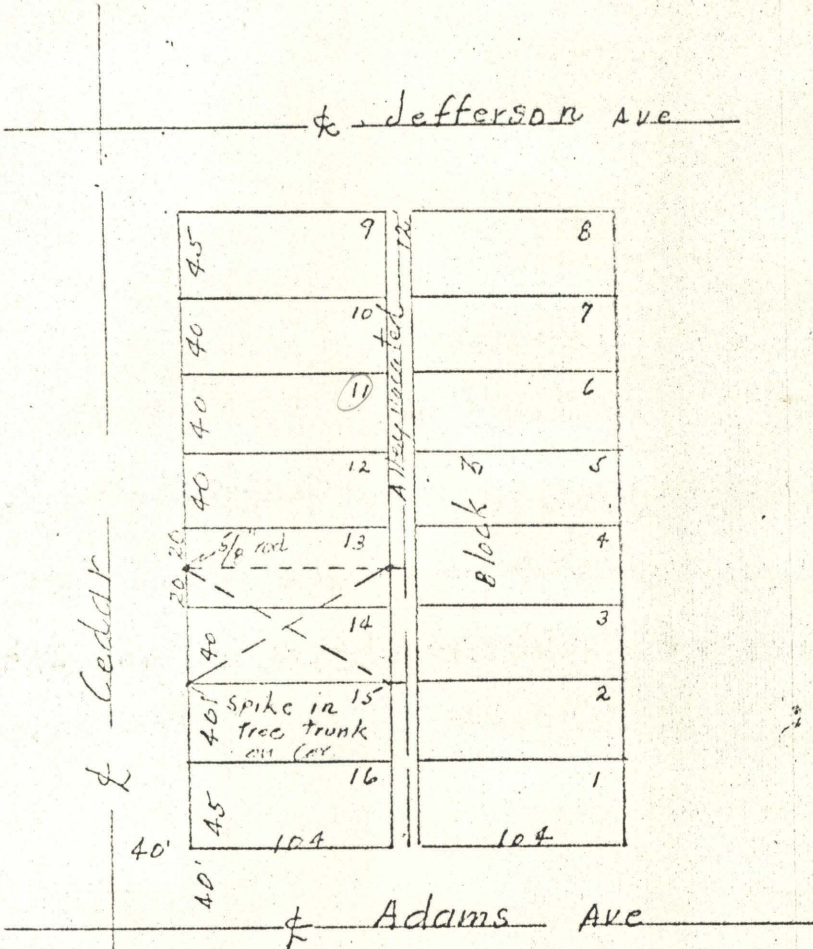

Scale 1" = 100'

Description; South $\frac{1}{2}$ of Lot 13 and Lot 14 of Block 3 of Grandy's Second Addition to La Grande, Oregon.

3 3860B 9500

