

18-69


Delmer Baker
907 J. Ave.
La Grande, Oregon

Aug 3, 1968

Description;
The North 75 feet of the east 110 feet of the South one half of Block 16
of Arnold's Addition to La Grande, Oregon.



Scale 1" = 100'

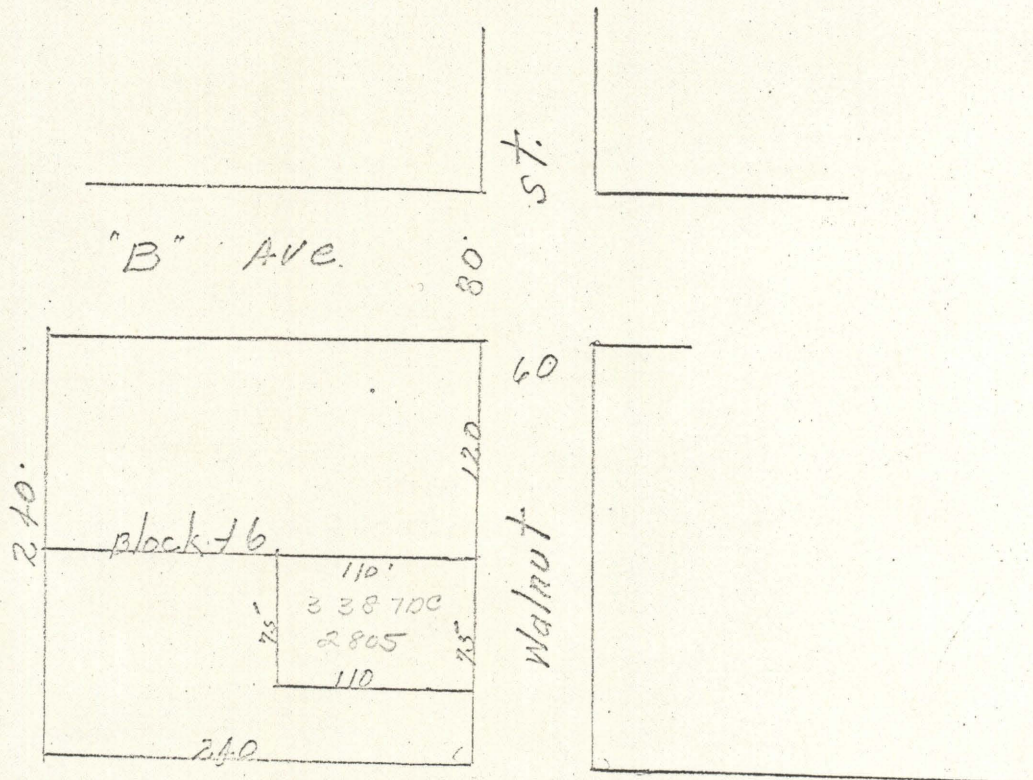

REGISTERED
OREGON
LAWYER

James G. Voelz

MAY 4, 1956
JAMES G. VOELZ
301

18-69

18-69