


Roman Catholic Church
Box 272
Elgin, Oregon

September 10, 1968

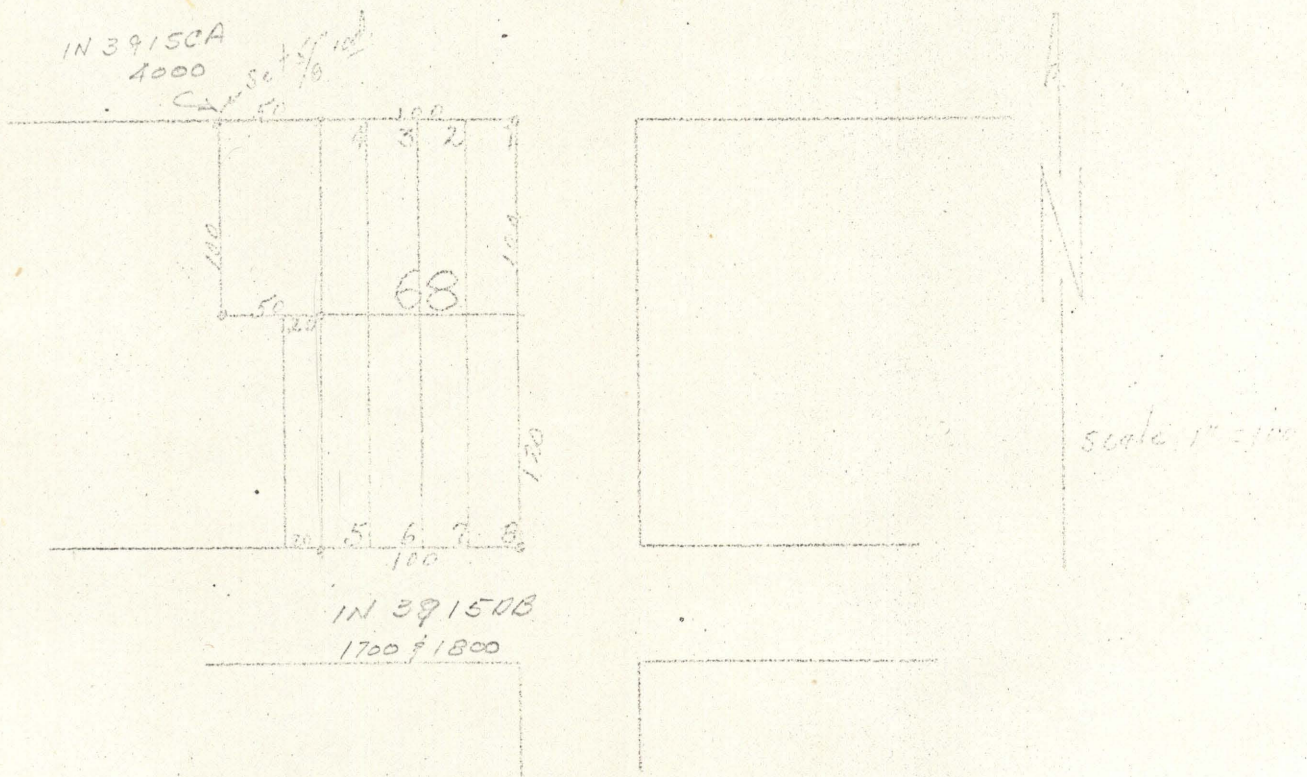

Description: Lots one through 8 of Block 68 of Hindman's Addition to Elgin, Oregon.

Beginning at the north west corner of Block 68 of Hindman's Addition to Elgin Oregon;
Thence west 50 ft.;
Thence south 100 ft.;
Thence east 50 ft.;
Thence North 100 ft. to point of beginning.

REGISTERED
OREGON
JAMES W. WALKER
1968

24-69

24-69