

27-69


69-12

C.F.

Ed Craig
Island City, Oregon

Sept. 11, 1968

Description; See Additional Sheet.

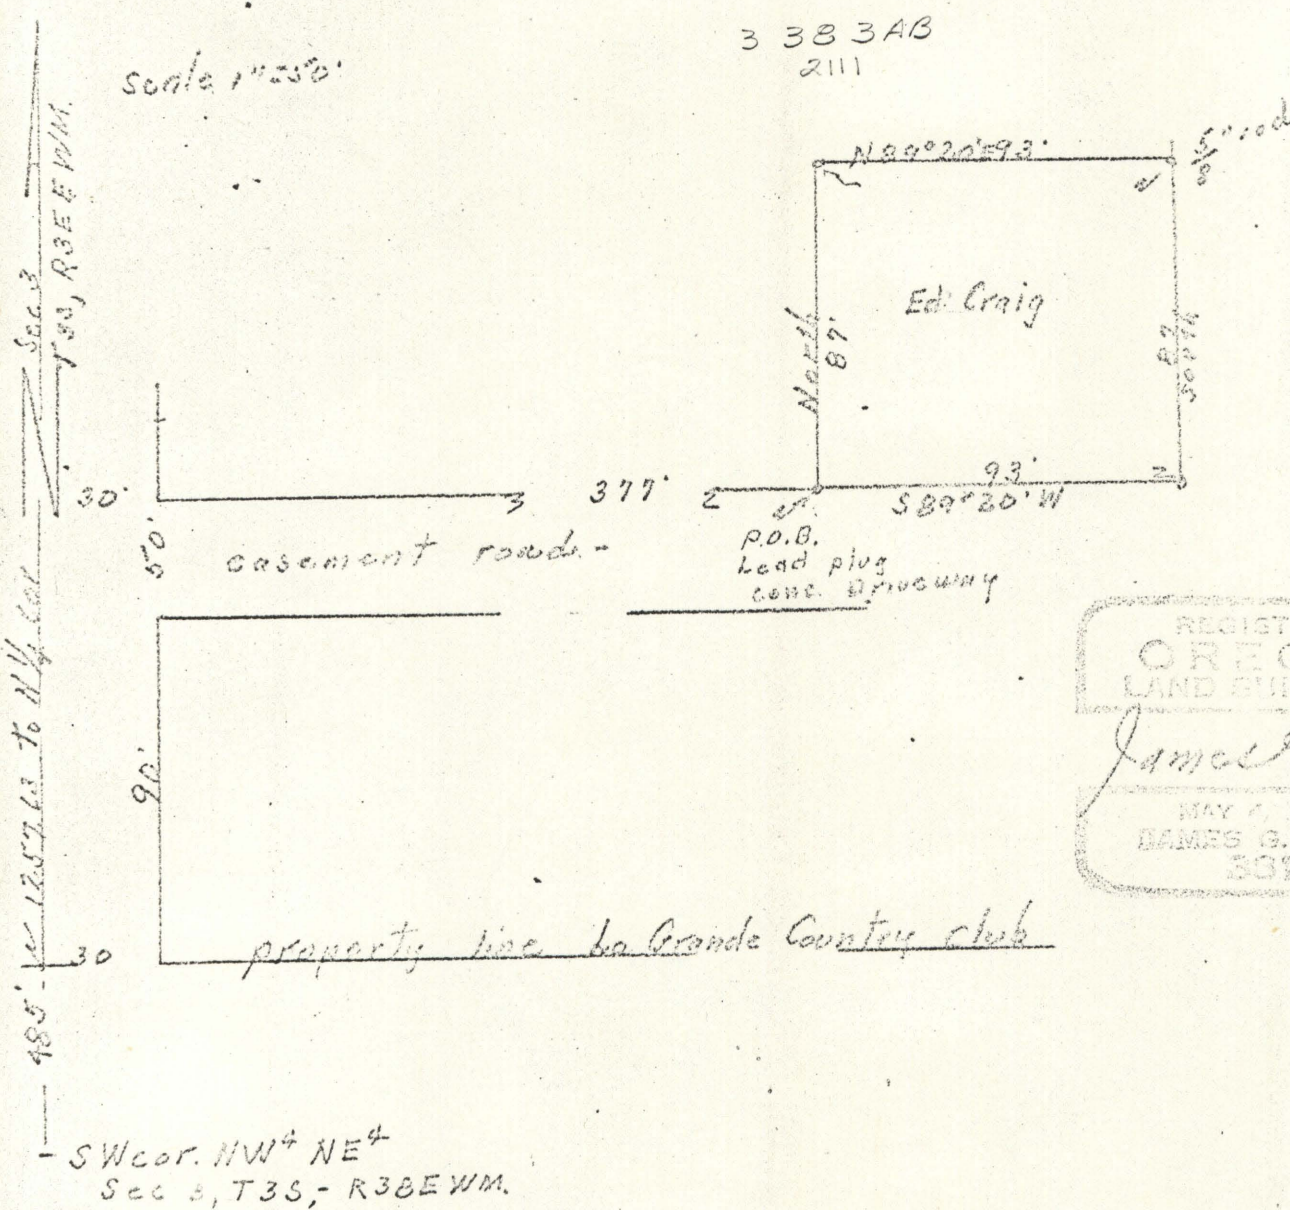

REGISTERED
OREGON
LAND SURVEYOR
James G. Voell
MAY 7, 1959
DAMES G. VOELL
331