


CH

James J. Hosey
Box 26, Baker, Oregon

September 24, 1968

Description: Lots 3, 4, 5 and, 6 of Block 4 of The Original Town of
Island City, Oregon.

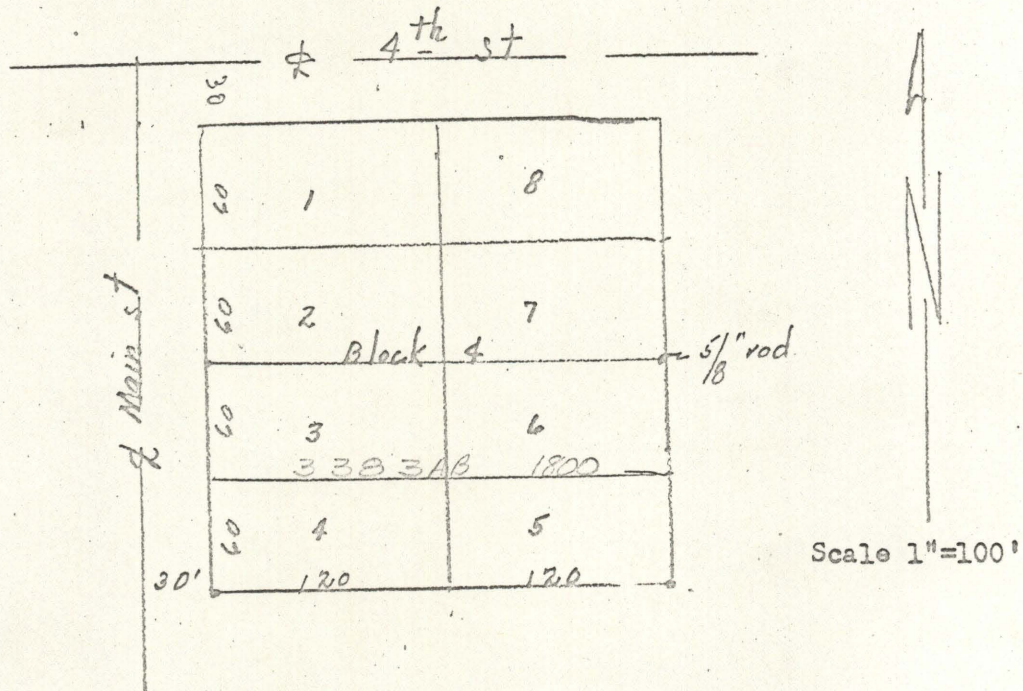

REGISTERED
OREGON
LAND SURVEYOR

James J. Hosey

MAY 4, 1968
JAMES G. VOELKE
301

30-69

30-69