


31-69

C. H.

Burt Mc Connell
602 Spring Ave.
La Grande, Oregon

Sept. 24, 1968

Description: Lots one and two of Block 3 of Romig's Addition
to La Grande, Oregon

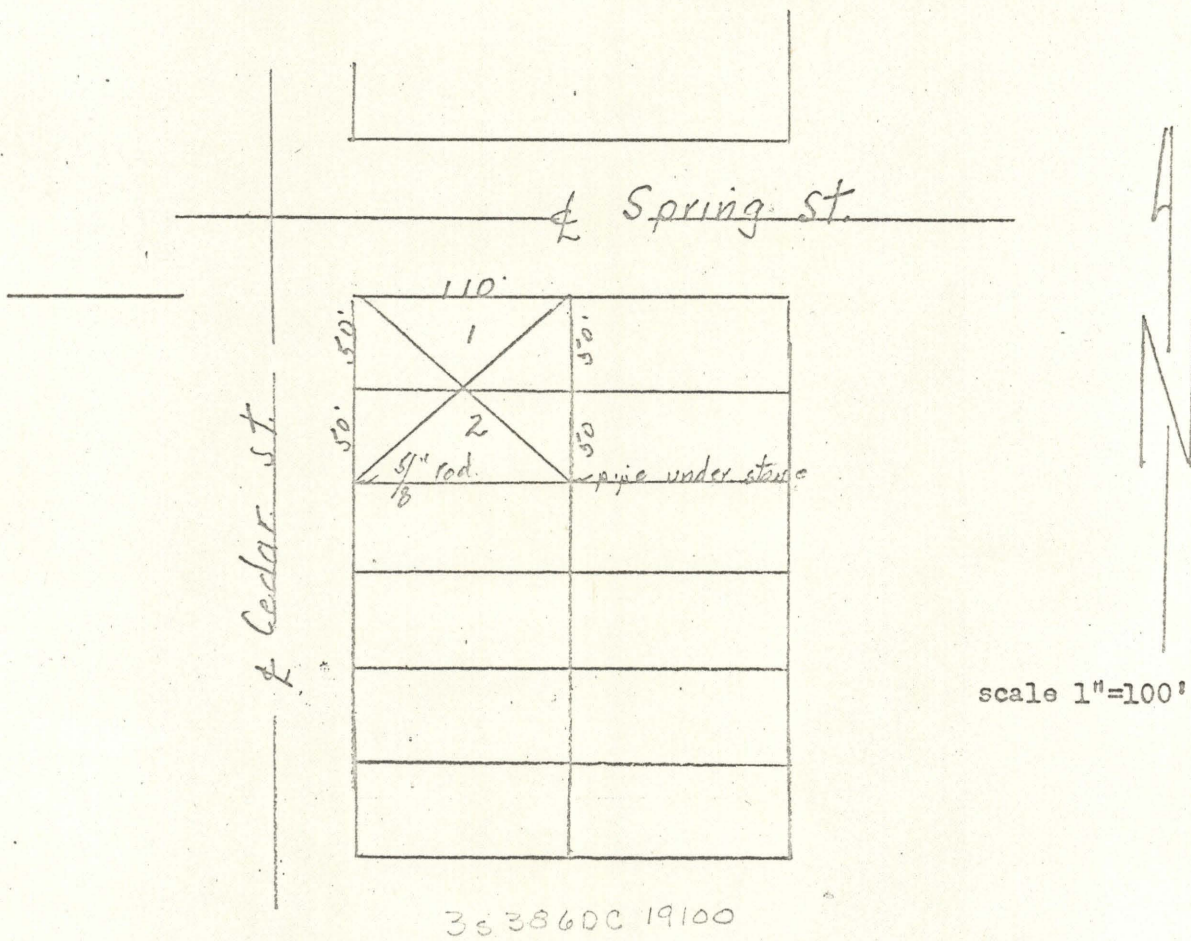

36386DC 19100

REGISTERED
OREGON
LAND SURVEYOR

James G. Voelz

MAY 4, 1956
JAMES G. VOELZ
391

31-69

31-69