34-69

34-69

Fred Gottschalk
North Cherry St.
La Grande, Oregon

Sept. 28, 1968
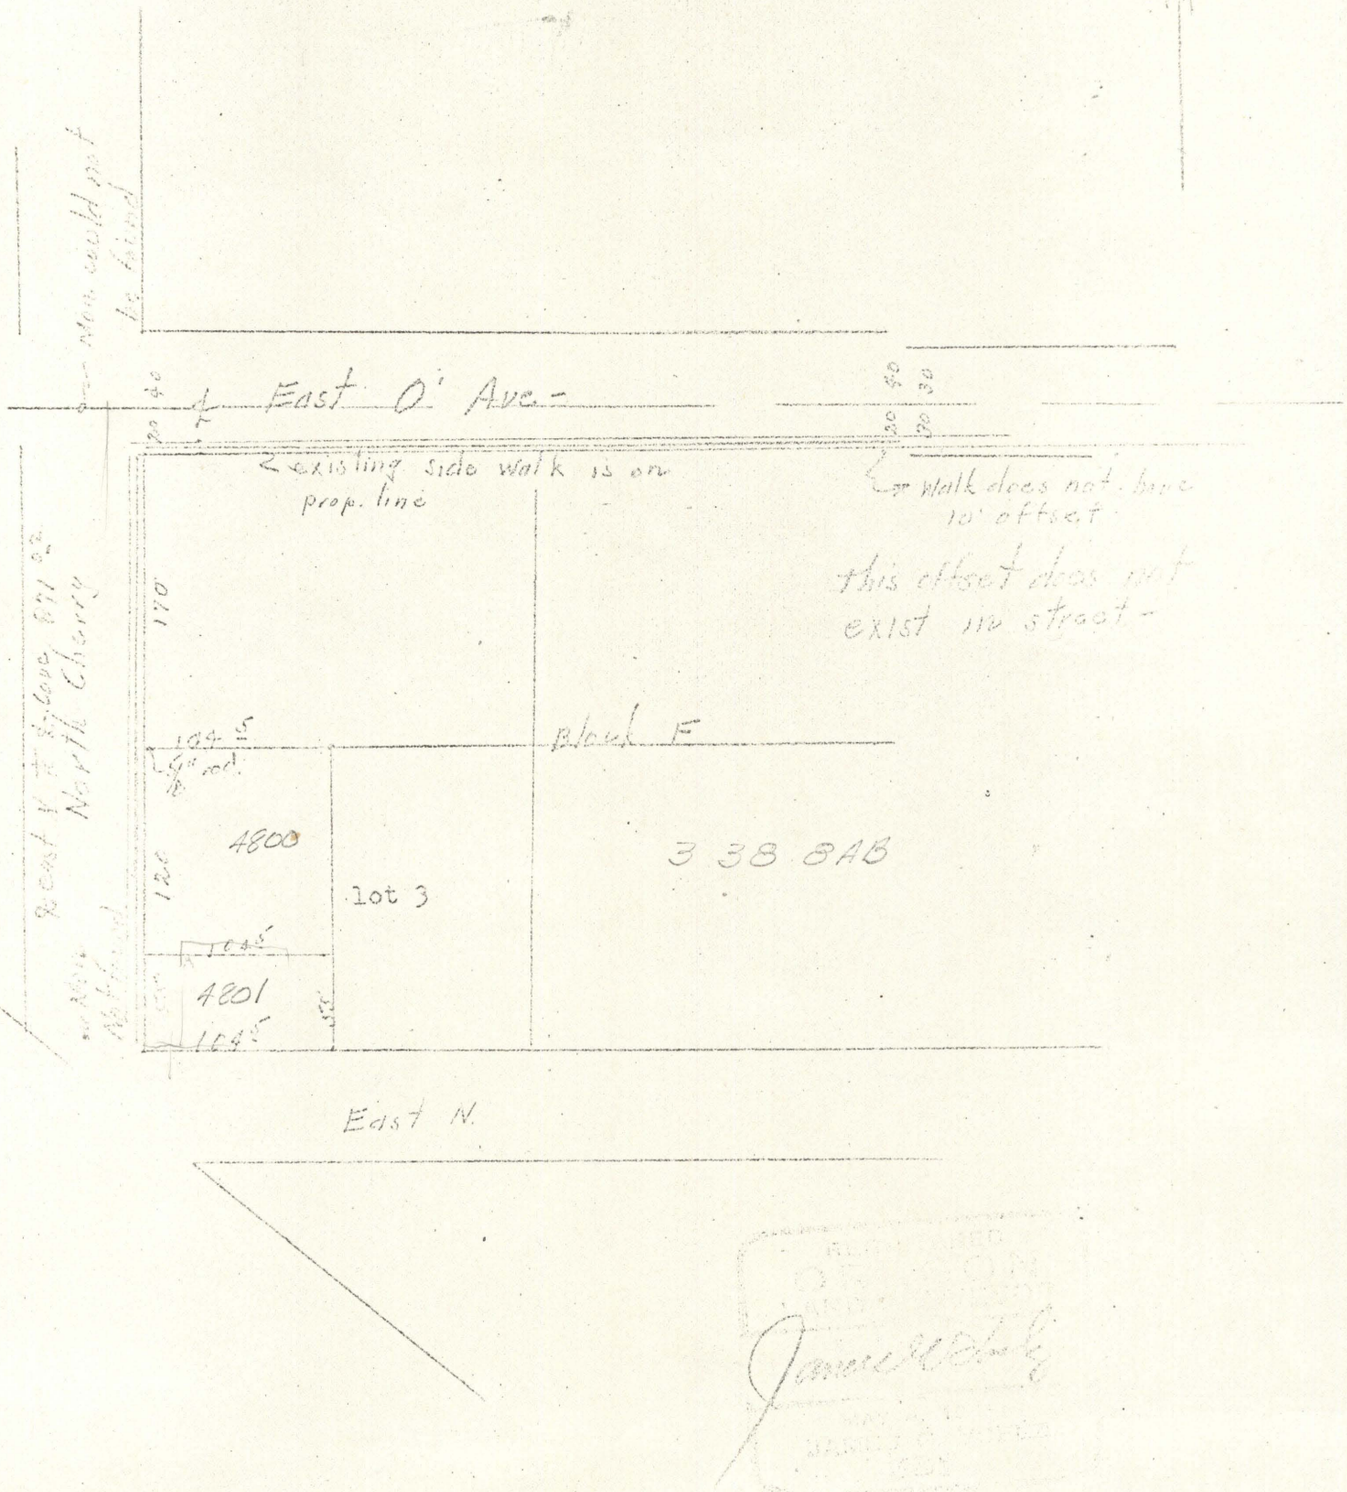
Description
West 104.5 Ft. of Lot 3 of Block F of Coggan's 2nd. Addition to La Grande, Oregon.