


58-69

C. House

Chetley Hire
P.O. Box 442
La Grande, Oregon

November 24, 1969

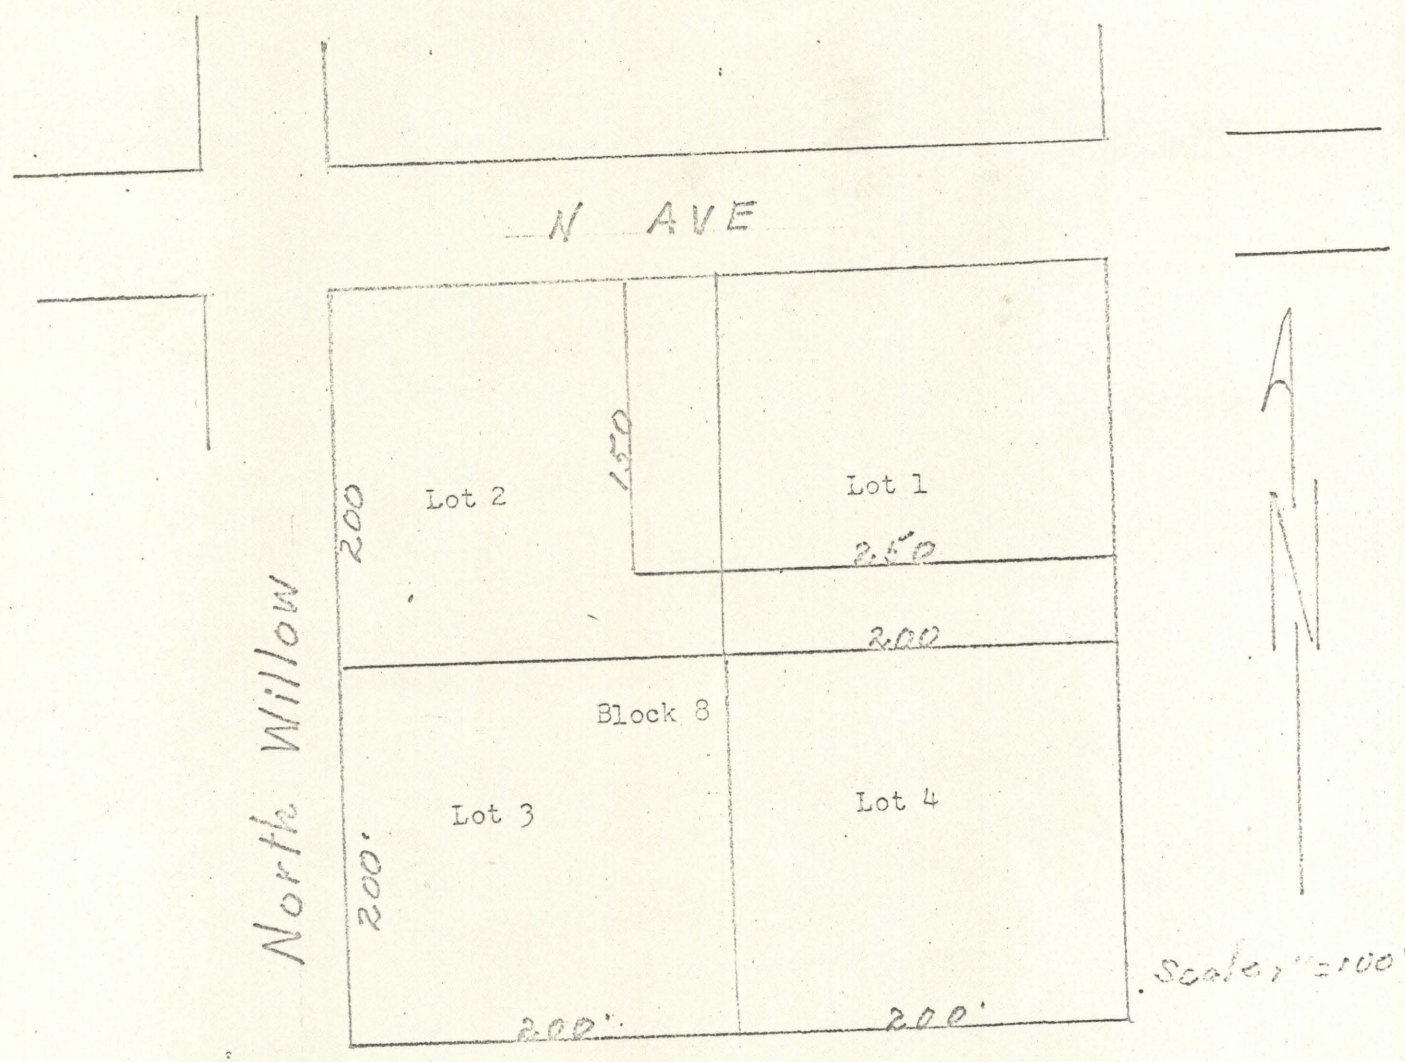

Description:
The north 150 feet of Lot 1 and the east 50 feet of the north 150 feet of lot 2 of Block 8 of Honan's Addition to La Grande, Oregon.

3 s 38 8 A 4
3401
3402

REGISTERED
OREGON
LAND SURVEYOR

James G. Voelz

MAY 4, 1958
JAMES G. VOELZ
381

38-69

38-69