


3-10

Archie Doud
Summerville, Oregon

Sept 24 and 25, 1969

IN 38
7500

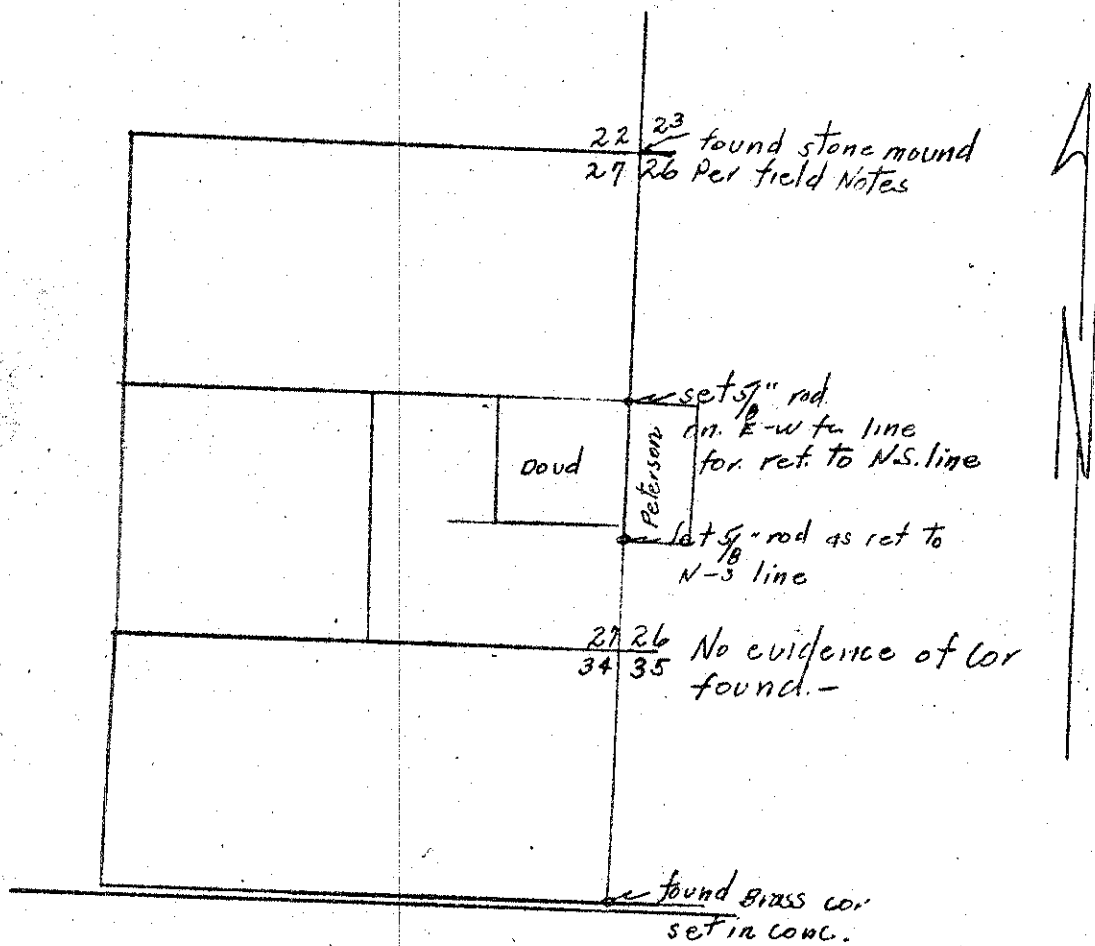

REGISTERED
OREGON
LAND SURVEYOR

James G. Volitz

MAY 4, 1959
JAMES G. VOLITZ
331