


6-70

C. Howell

Mrs. Lois Gray  
Rt. #2 Box 43  
Walla Walla Washington 99362

November 7, 1969

2N 39

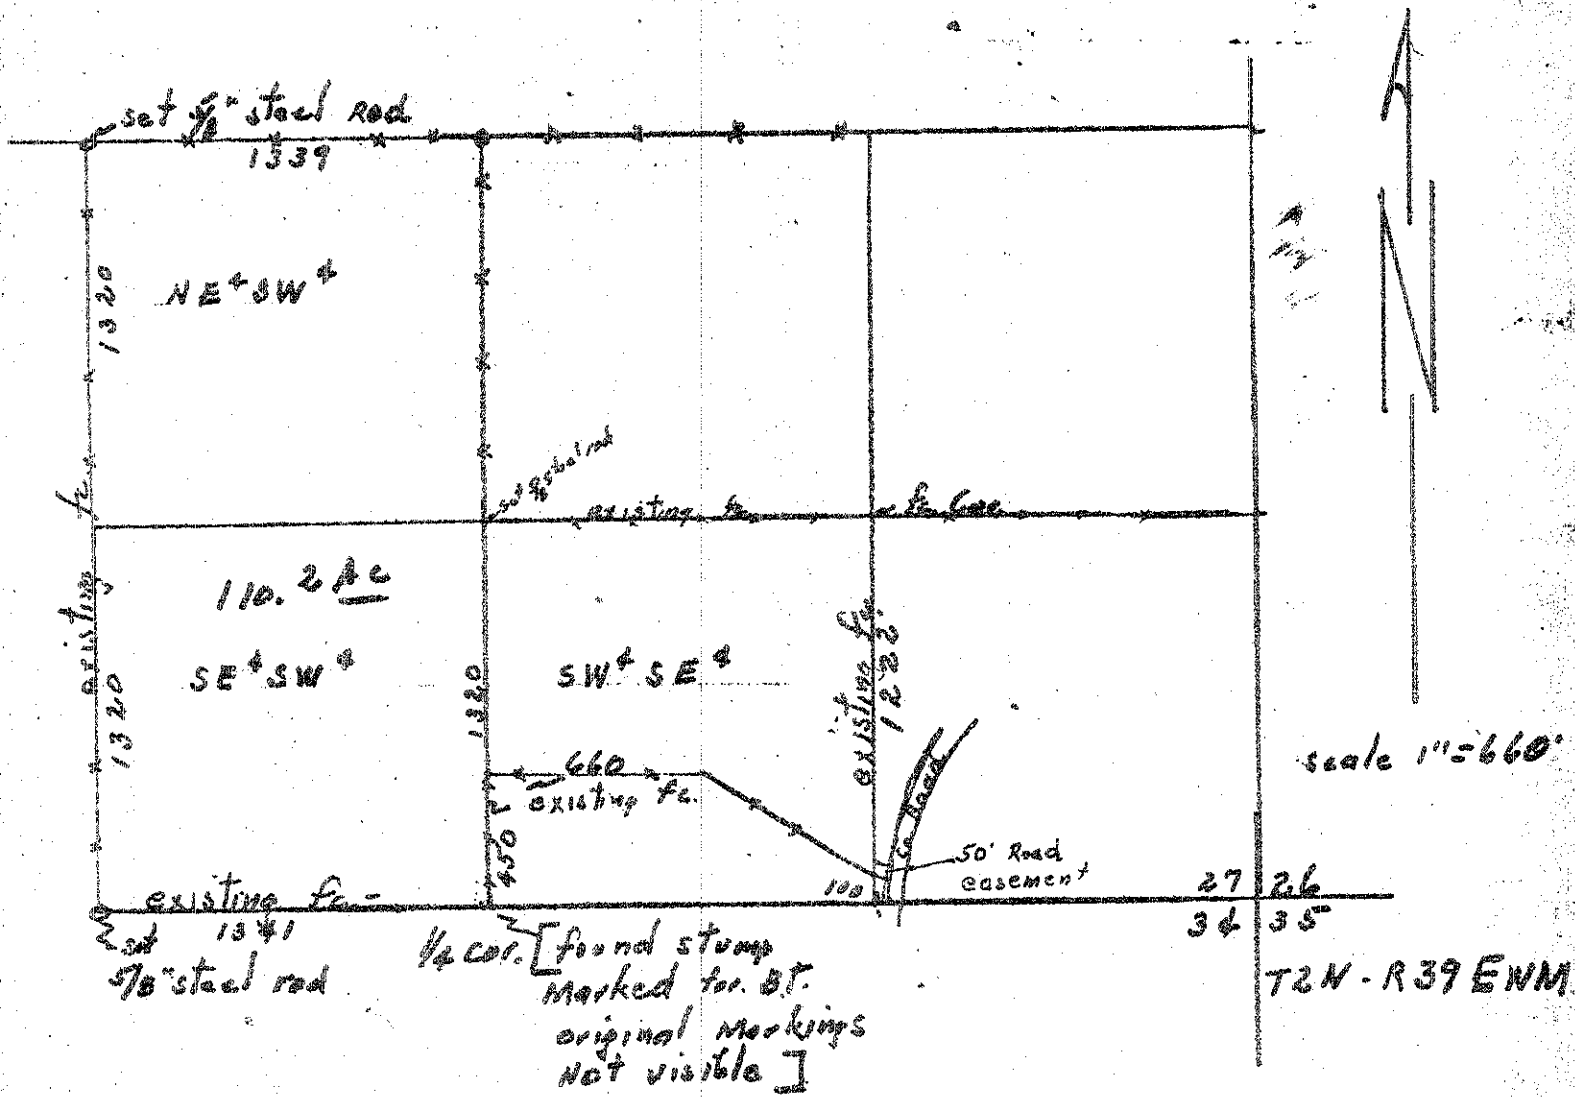

REGISTERED  
OREGON  
LAND SURVEYOR

*James G. Voelz*

MAY 4, 1969  
BAMES G. VOELZ  
381