

1A-70

CH


William A. Bull Estate
Mrs Eileen Johnson
1701 9th Street
La Grande, Oregon

October 1, 1970

SE $\frac{1}{4}$ cor Sec 26 T1S, R38EWM

Legal descriptions.

- #1 The east 825 feet of SE $\frac{1}{4}$ S26 T1S, R38EWM
- #2 The SE $\frac{1}{4}$ of S 26, T1S, R38EWM excepting the east 825 ft.

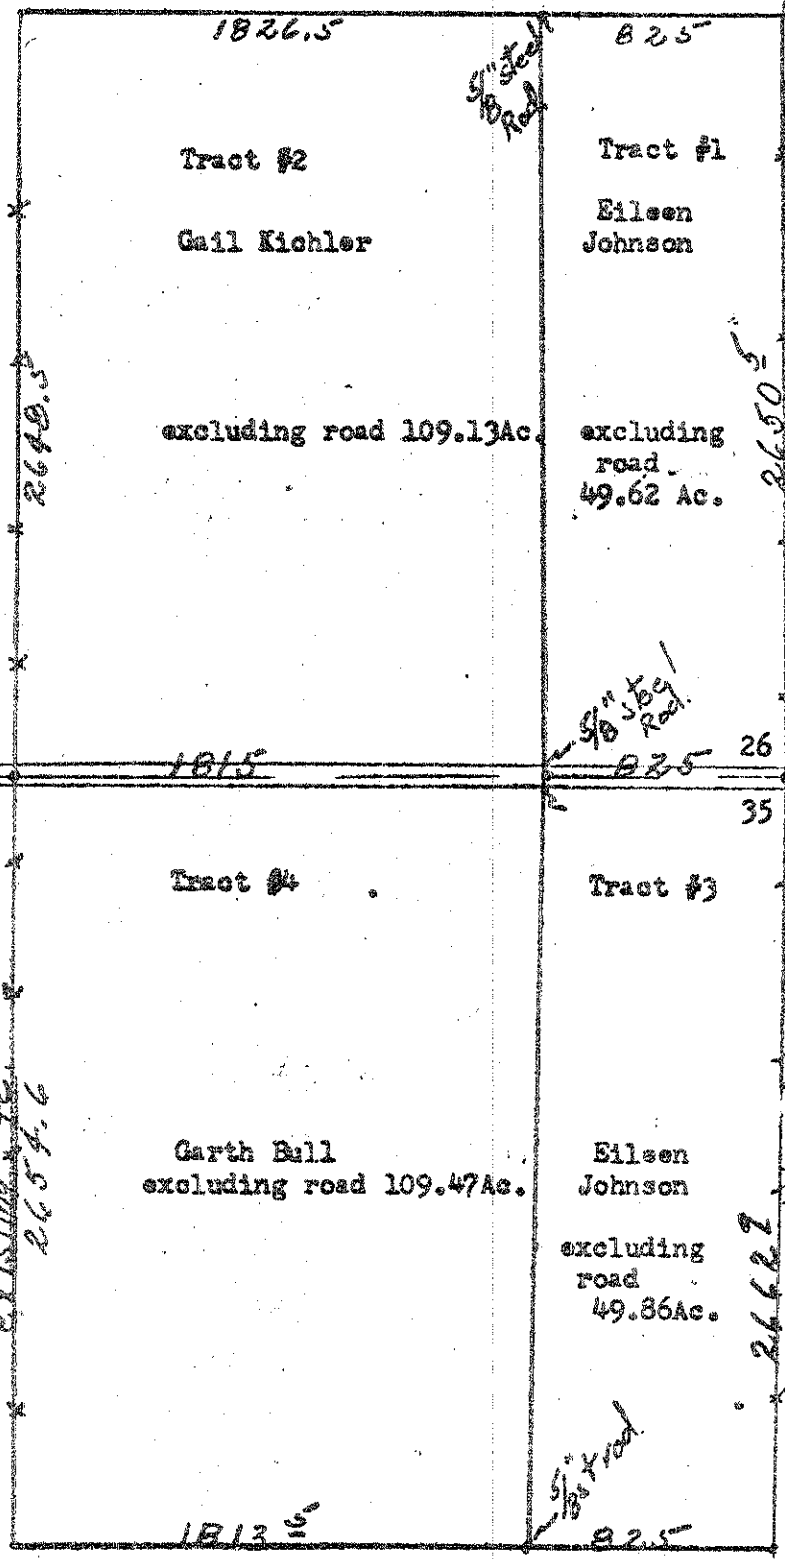

scale 1"=660'

REGISTERED
OREGON
 LAND SURVEYOR
James G. Voelz
 MAY 4, 1959
JAMES G. VOELZ
 681