



NOTE: County Road as shown on this map is as located on the ground.

R 37 E R 38 E
T 3 S S 13 S 18
mound of stone

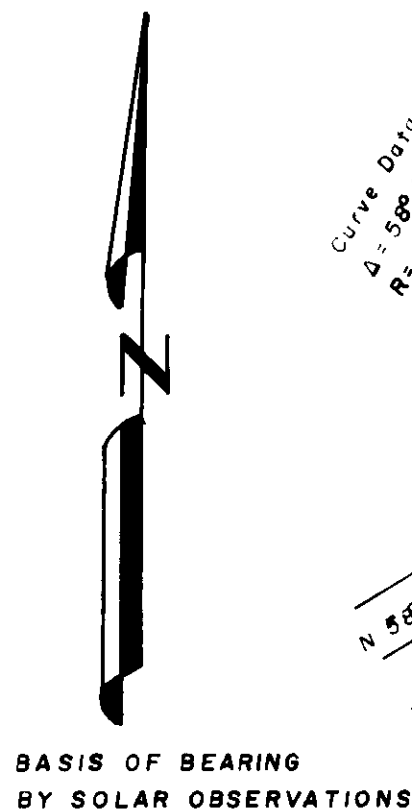

Curve Data
Δ = 58° 55' 30"
R = 157.73
T = 89.10
L = 162.21

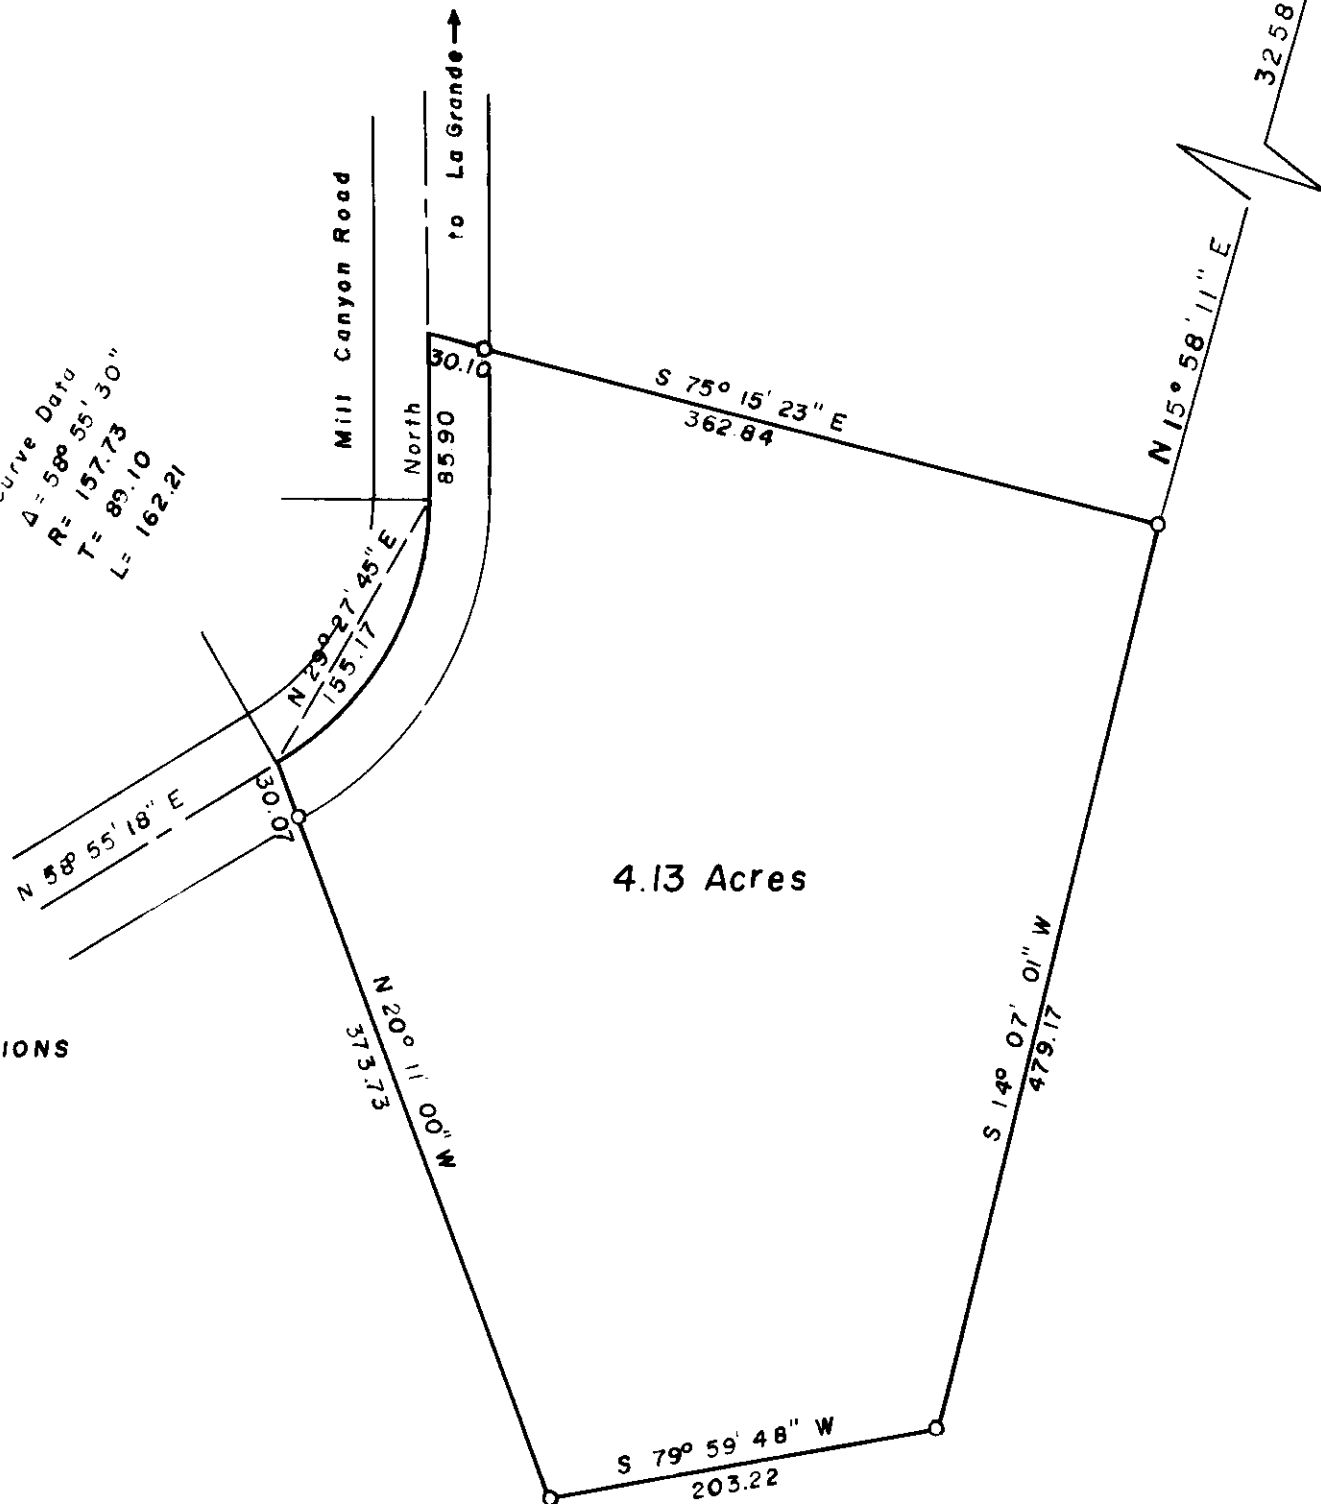

LEGEND

- o Set 5/8" x 30" Iron Pin
- County Road Center Line
- ===== County Road Right of Way

John Day, Oregon

BAGETT-GRIFFITH-FERGUSON		
John Day, Oregon		
Map of Survey		
A PARCEL LYING IN THE NE 1/4		
SECTION 24, T 3 S R 37 E W.M.		
UNION COUNTY OREGON		
SURVEYED FOR	ROY BECHTEL	
SURVEYED BY	D.M.F. & D.G.	Oct. 1970
Scale: 1" = 100'	Drawn by: D.M.F.	Oct. 1970