


Ronde Valley Lumber Co.
Union, Oregon

May 26, 1969

Description:

Lots 3, 4, 5, 6, and 7 of Block 3 of Union, Oregon

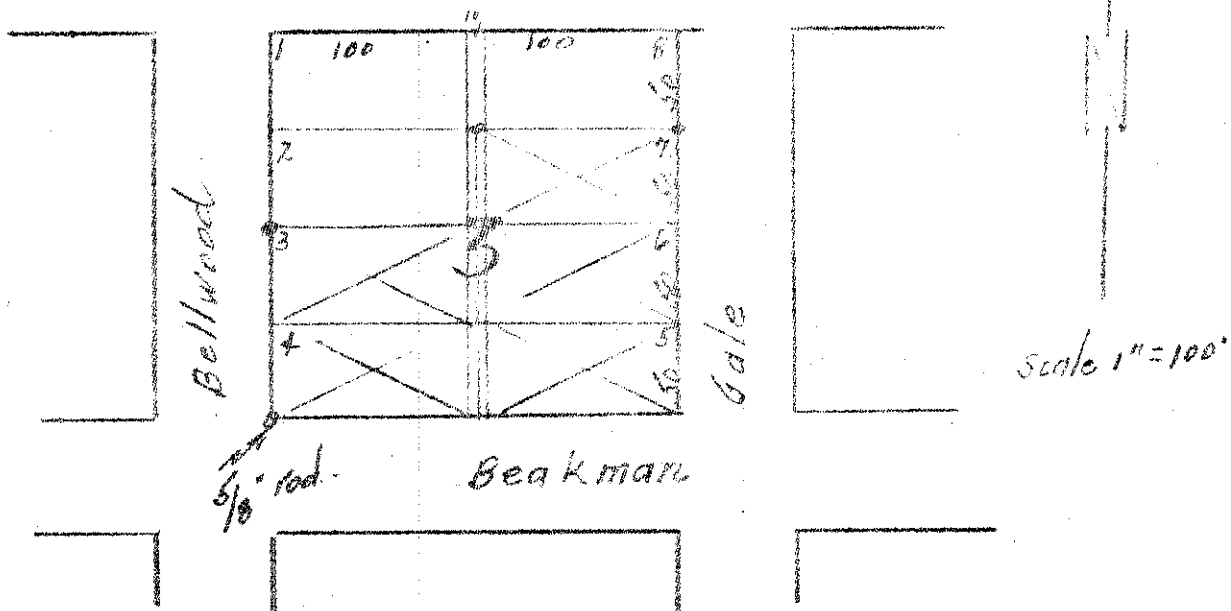

REGISTERED
OREGON
LAND
James H. Volle
MAY 26 1969
JAMES H. VOLLE
511