


28-70

George W. Saunders  
7111 East 18th. Street  
Tucson Arizona 85710

September 15, 1970

Description;  
The north 330 feet of SW $\frac{1}{4}$ SW $\frac{1}{4}$  of Section 9, T1S, R38EWM.  
containing 10 acres.  
Subject to a 20 foot road easement on the east end.

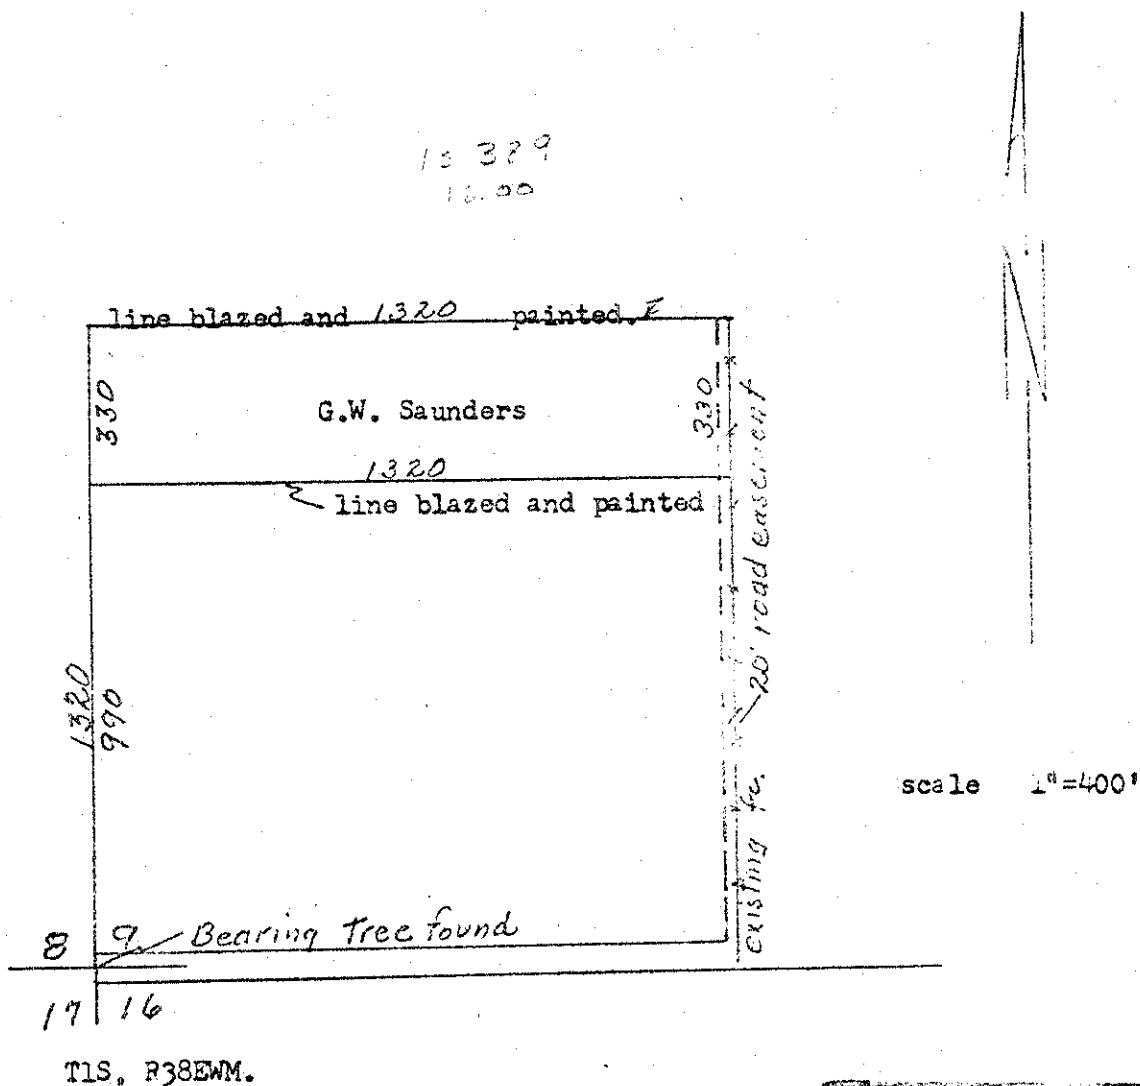

REGISTERED  
OREGON  
LAND SURVEYOR

*James G. Voelz*

MAY 4, 1953  
JAMES G. VOELZ  
351

28-70