


30-70

William Patrick Rollins estate
% Burleigh, Carey & Gooding
Fourth and Washington Ave.
La Grande, Oregon


April 18, 1970

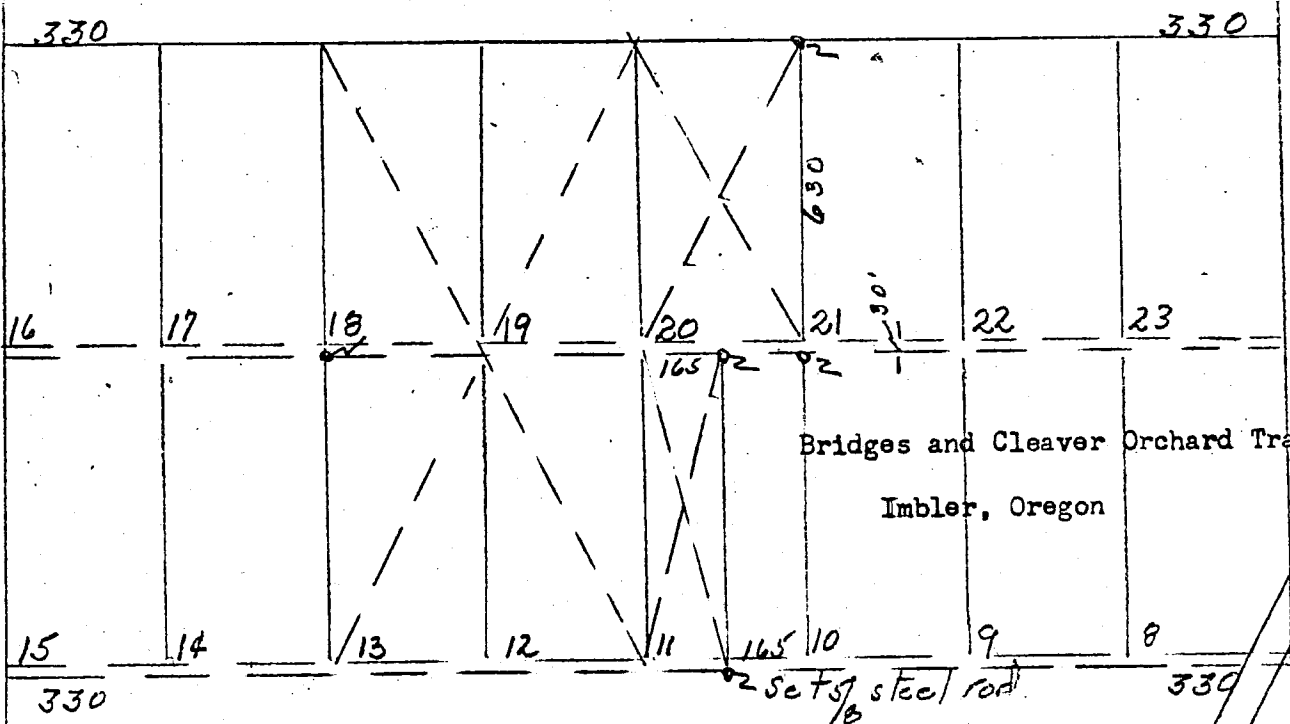

scale 1"=400'

Bridges and Cleaver Orchard Tracts
Imbler, Oregon

Description;
All of tract 12, 13, 18, 19, 20 and the west half of tract 11
of Bridges & Cleaver Orchard Tracts which are located in SE 1/4 of
Section 17, T1S, R39EWM.

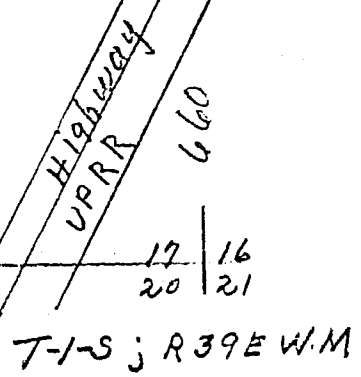

REGISTERED
OREGON
LAND SURVEYOR

James G. Voelz

MAY 4, 1953
JAMES G. VOELZ
331

18 39 17
1202
1401

30-70