


C.H.

4/1-70

Ralph Badgley
1201 - 10 th. St.
La Grande, Oregon

June 26, 1970

T.3.S R.37 E W.M.

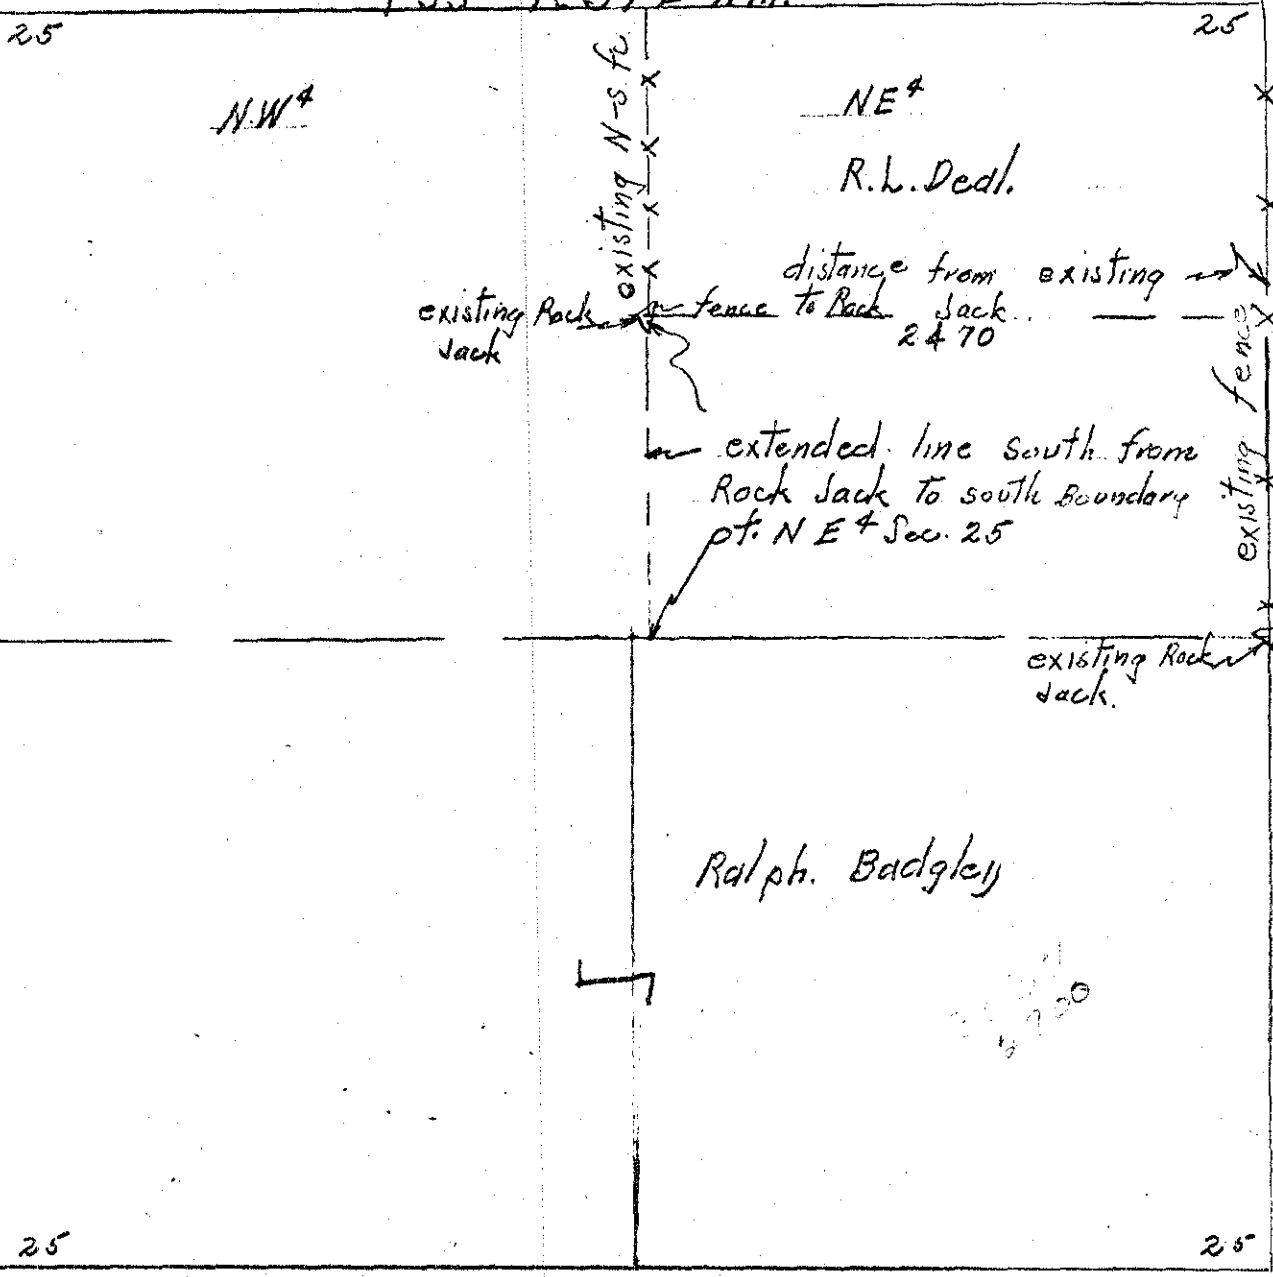

REGISTERED
OREGON
LAND SURVEYOR

James G. Voelz

MAY 4, 1938
JAMES G. VOELZ
381

N
Scale 1" = 880'

4/1-70