

Mr. Mc Donald  
Box 408  
Lakeview, Oregon


Feb. 9, 1970

( ) data of record

Block 3 McCully Add.  
(found)  
steel shaft SW cor.

ASH Street

Scale 1" = 100'

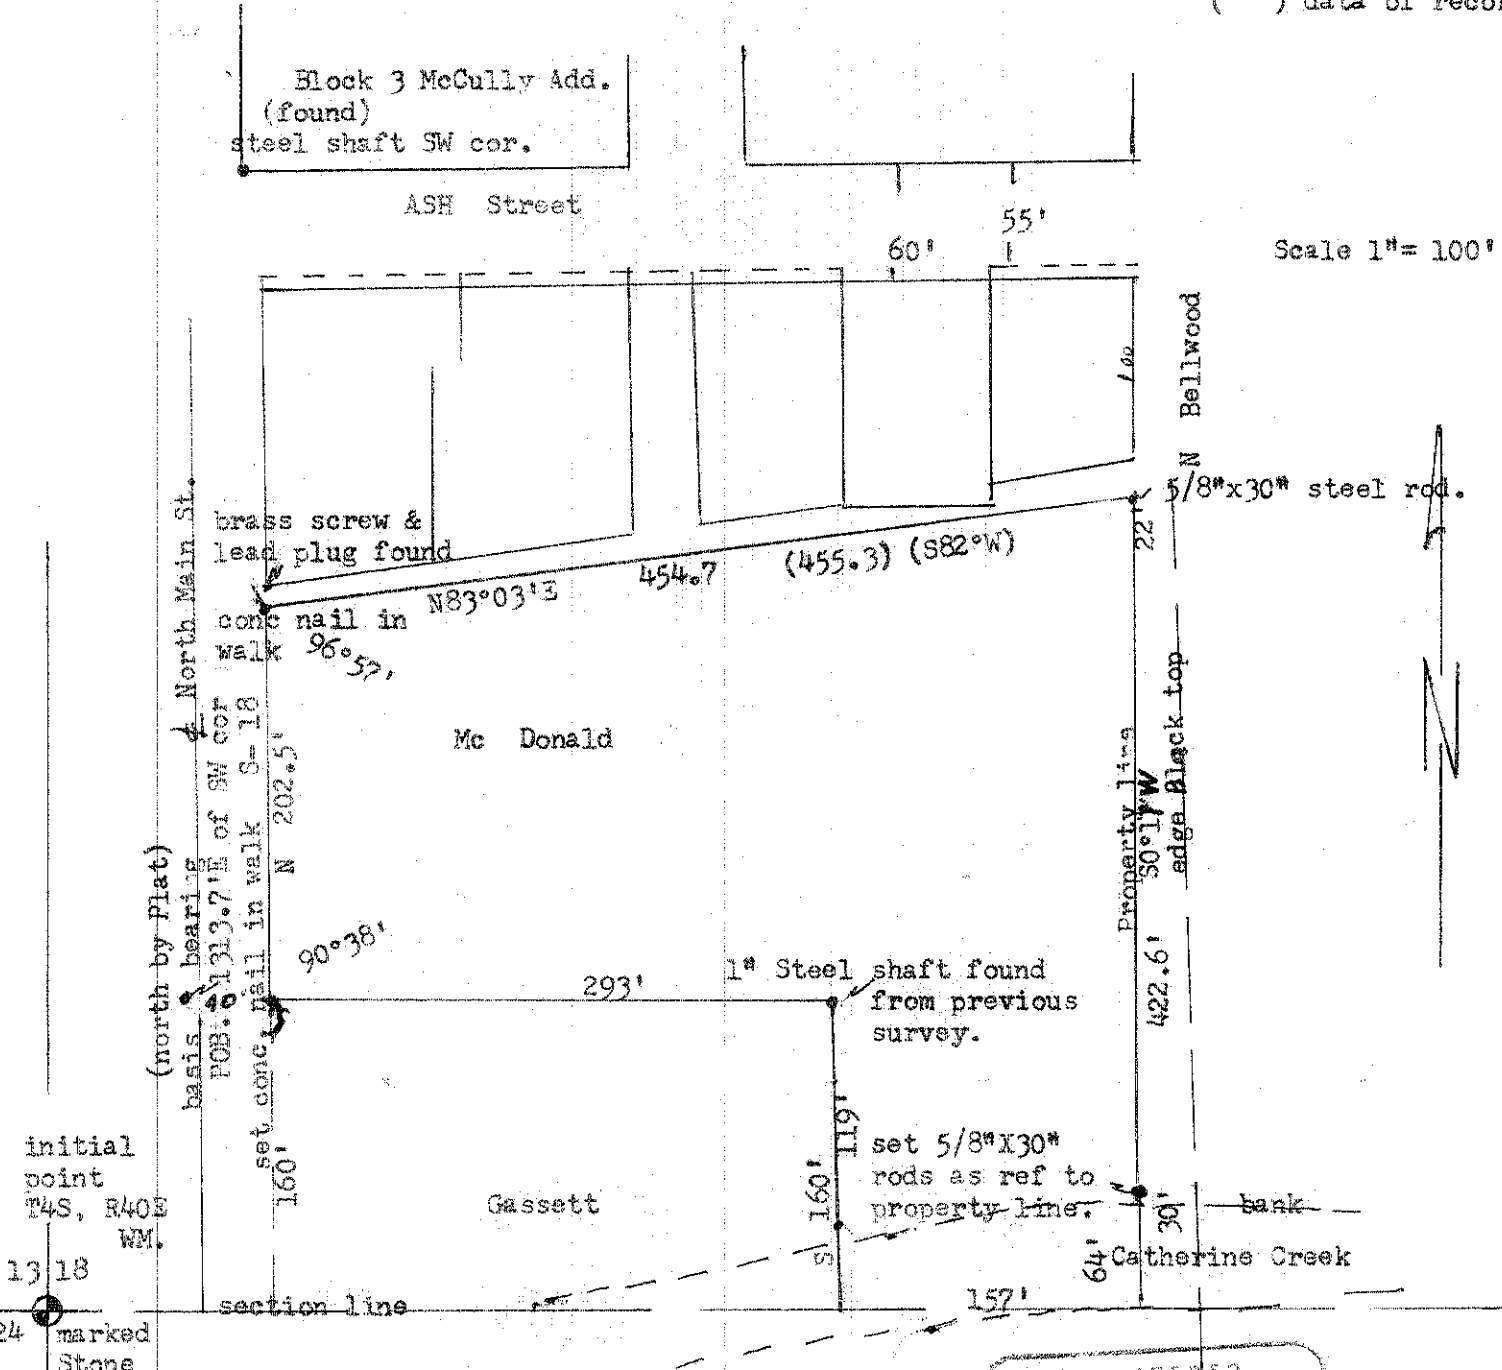

REGISTERED  
PROFESSIONAL  
LAND SURVEYOR  
*James G. Voeltz*  
OREGON  
MAY 4, 1956  
JAMES G. VOELTZ  
381

44-70

44-70