
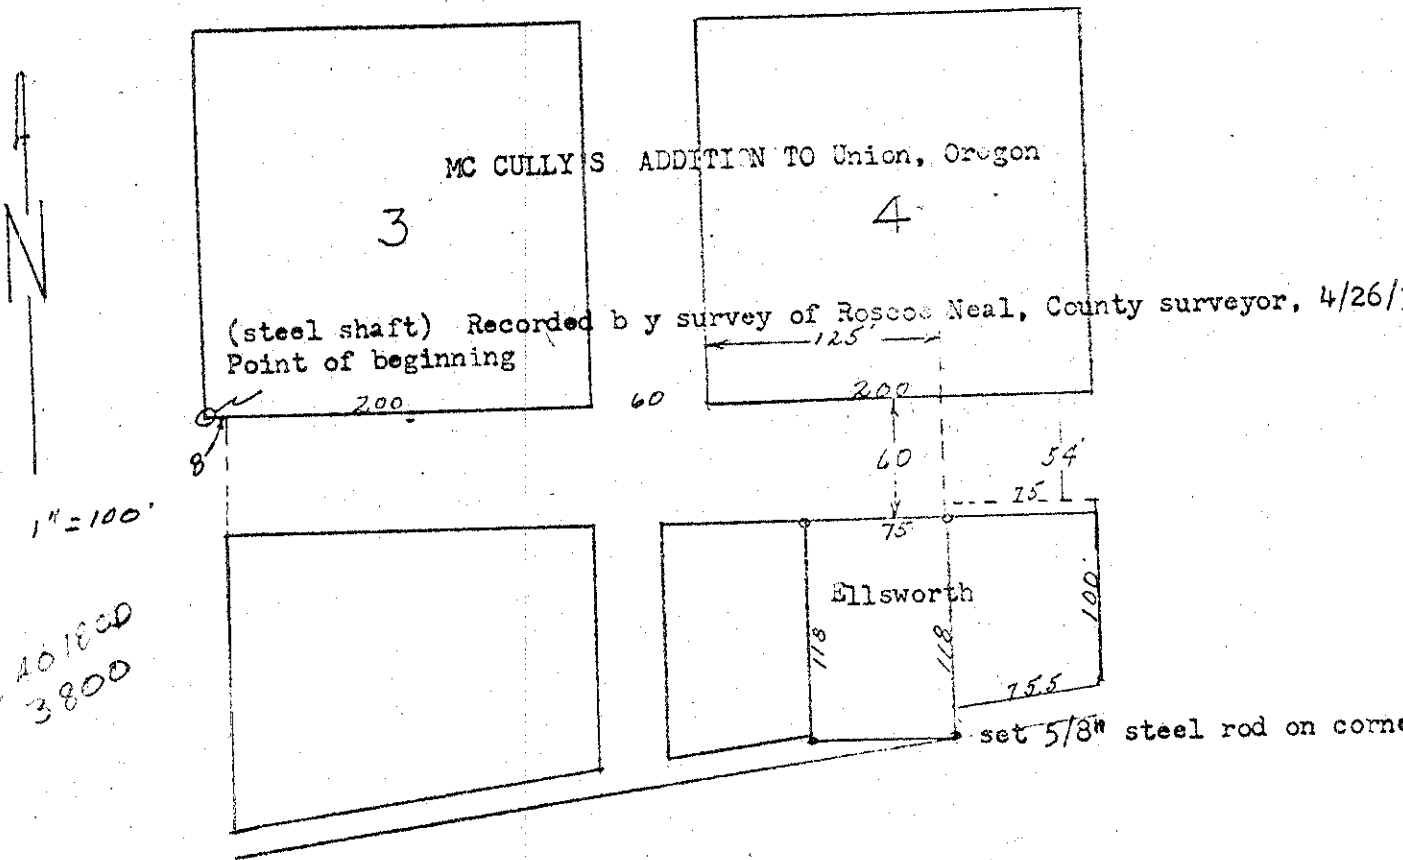


C.H.

45-70

V.S. Ellsworth
244 E. Ash
Union, Oregon

July 24, 1970

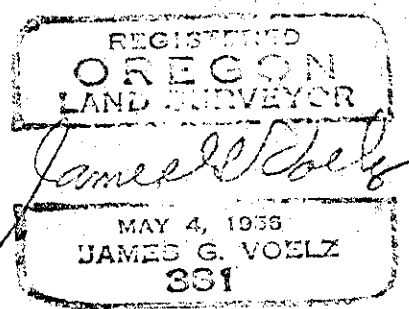

Description:
Beginning at a point 125 feet east and 60 feet south of southwest corner of Block 4 of Mc Cully's Addition to Union, Oregon.
thence west 75 feet;
thence south 118 feet;
thence east 75 feet; (legal description reads a little north of east with out bearing given)
thence north 118 feet more or less to point of beginning.

45-70