


A6-70

Ed Volker
Cove, Oregon

March 30, 1970

Description;

Block 8 of West Union Addition to Union, Oregon.

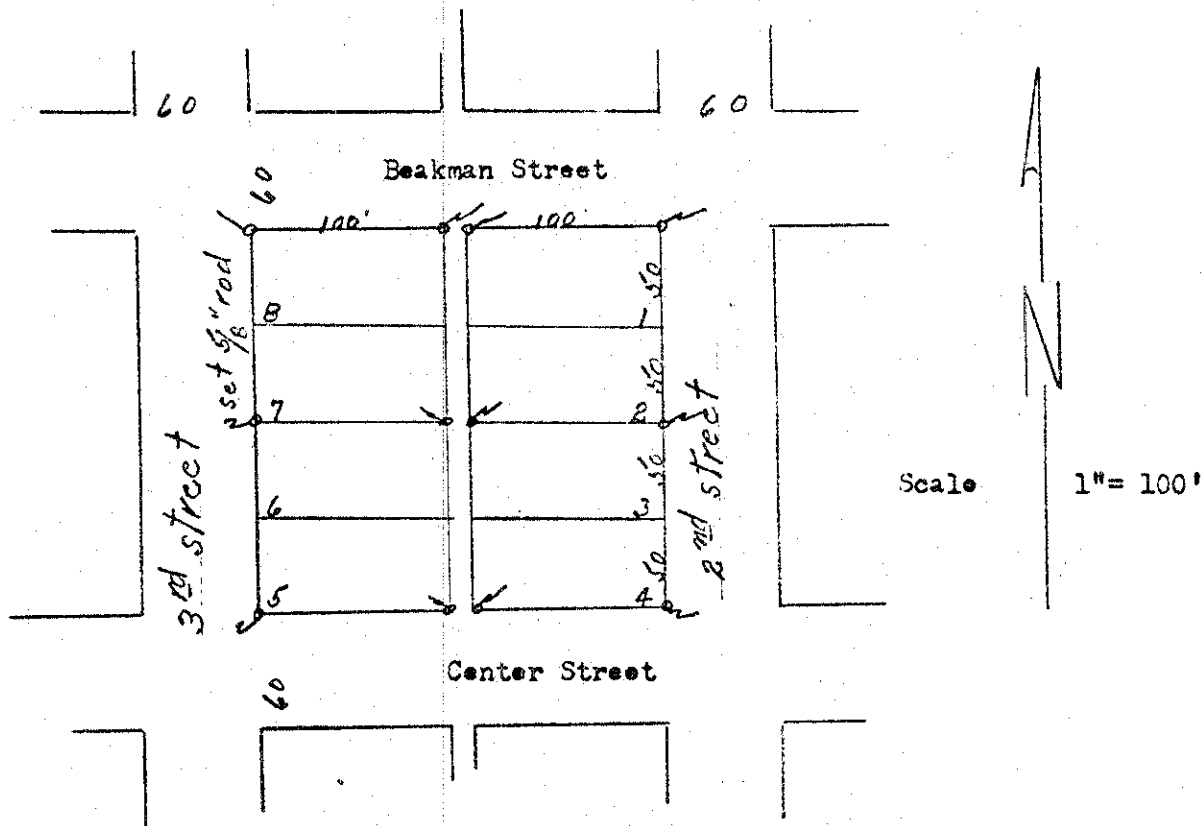

201988
3700
3600
3601

REGISTERED
OREGON
 LAND SURVEYOR
James G. Voelz
 MAY 4, 1953
 JAMES G. VOELZ
 331

A6-70