


47-70

Oscar and Wannetta Wilson
Telocaset, Oregon

Sept 18, 1970

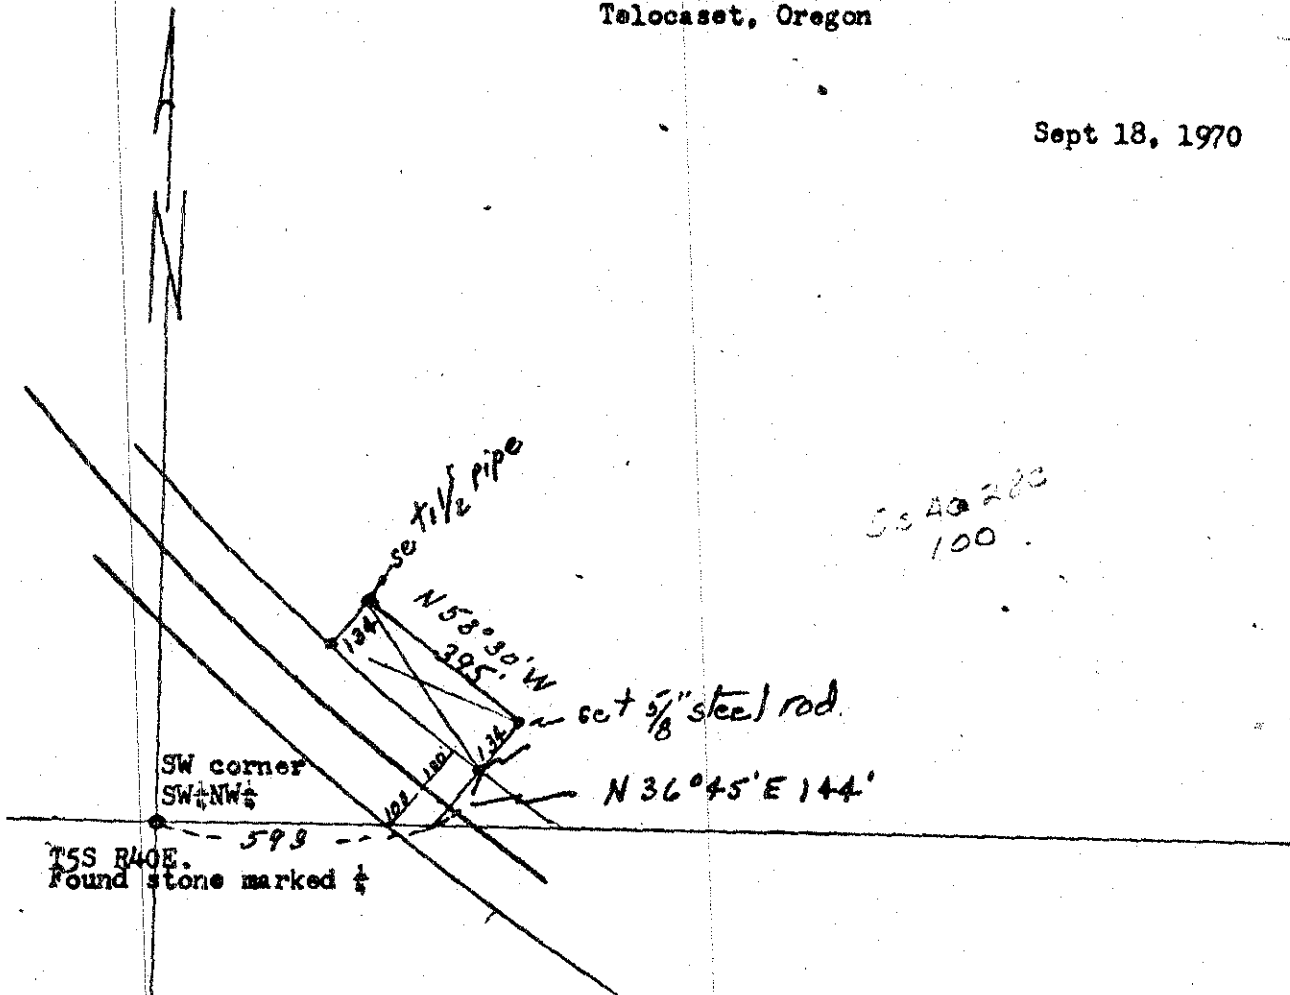

5540280
100

Description;

Commencing at the southwest corner of the northwest quarter (NW $\frac{1}{4}$) of section 28, T5S R40EWM; and running thence east 593 feet; thence N36°45'E 144 feet to a point on the north line of the O-W-R-N & N. Company right of way, (now Union Pacific Railroad), which is the point of beginning; running thence N34°45'E 134 feet; thence N53°30'W 395 feet; thence S34°45'W 134 feet to the line of O-W-R-N Company right of way; thence southeasterly along said right of way to the point of beginning.

REGISTERED
OREGON
LAND SURVEYOR

James G. Voelz
MAY 4, 1958
JAMES G. VOELZ
381

47-70