Jay Loudermilk
Rt. #1 Box 234B
La Grande, Oregon

Aug 19, 1970

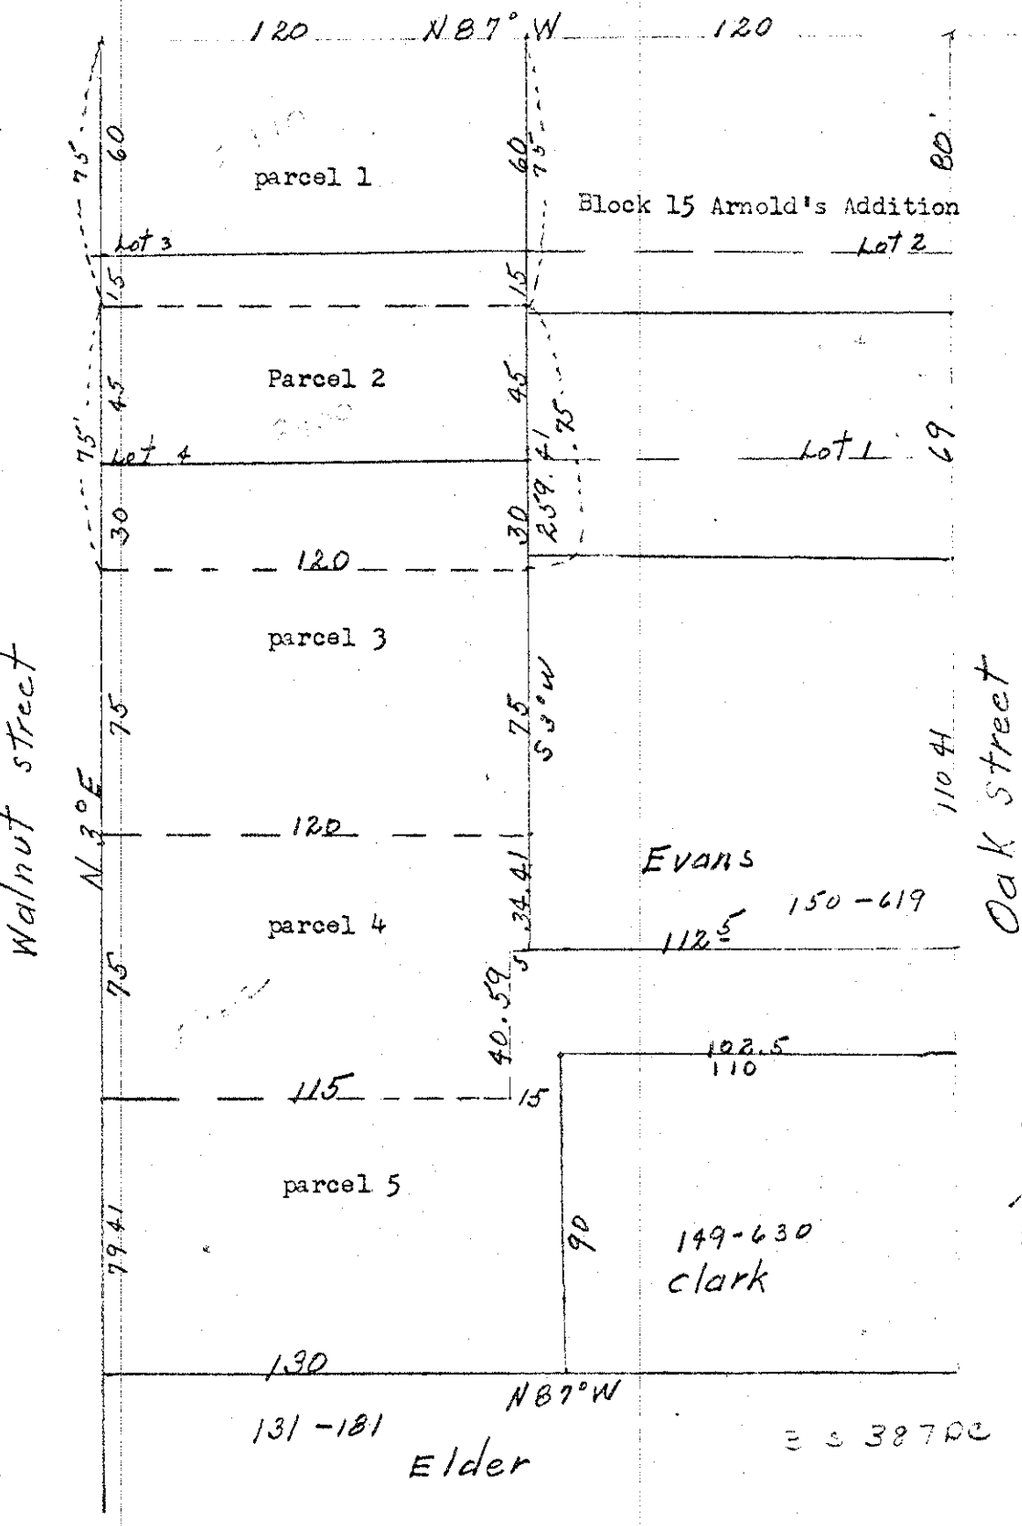

REGISTERED
OREGON
LAND SURVEYOR
James G. Voelz
MAY 4, 1953
JAMES G. VOELZ
301