


57-70

Escamilla
1906 North Greenwood
La Grande, Oregon

March 31, 1970

Description;
Lots 11, 12, and 13 of Block 151 of Chaplin's Addition
to La Grande, Oregon.

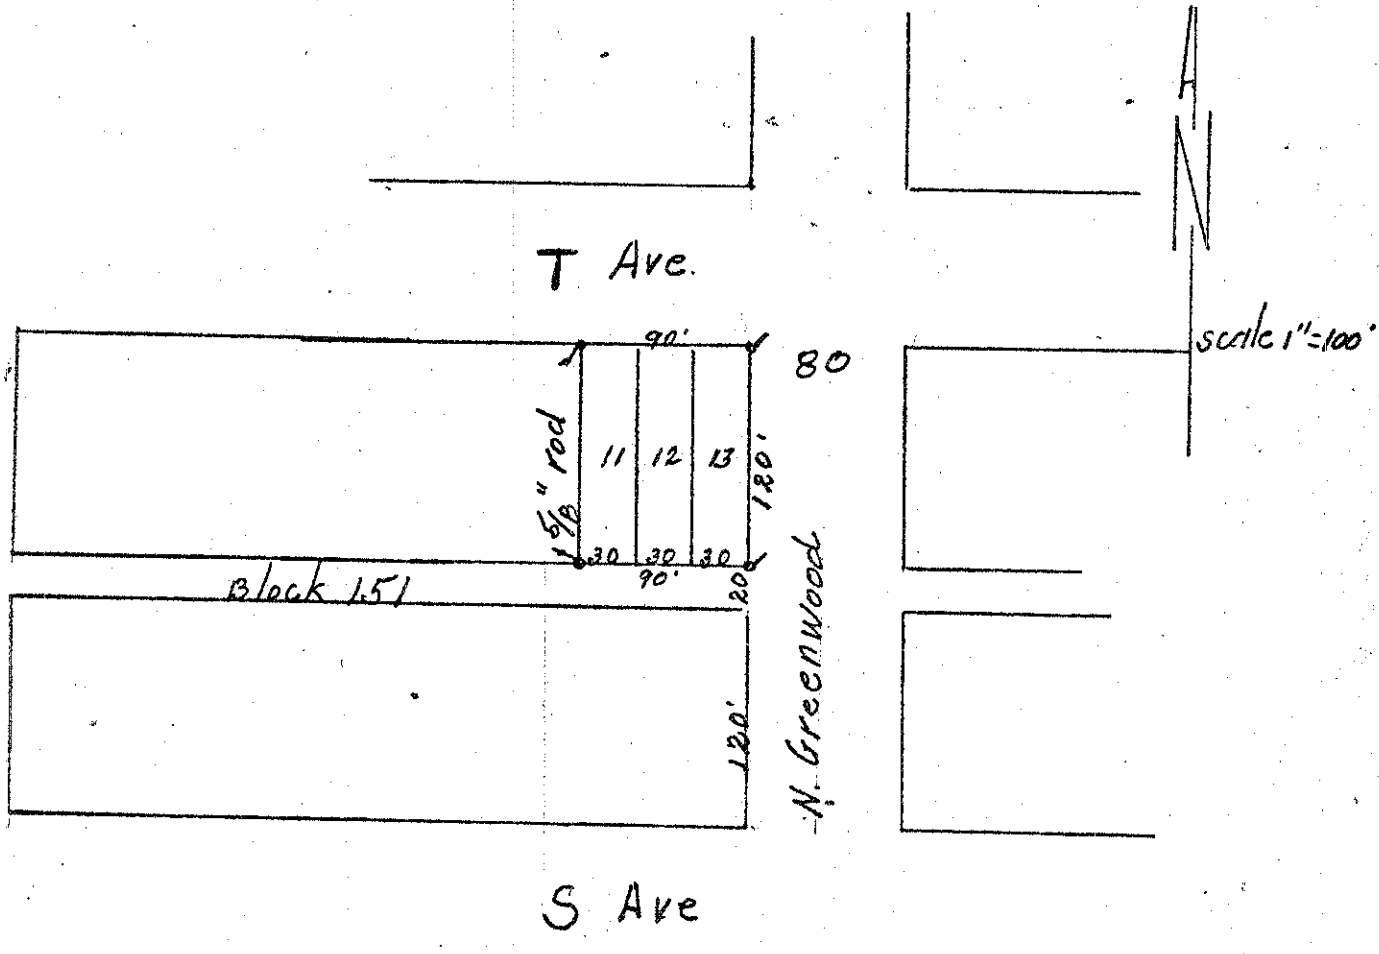

REGISTERED
OREGON
LAND SURVEYOR

James G. Voelz

MAY 4, 1958
JAMES G. VOELZ
391

57-70