
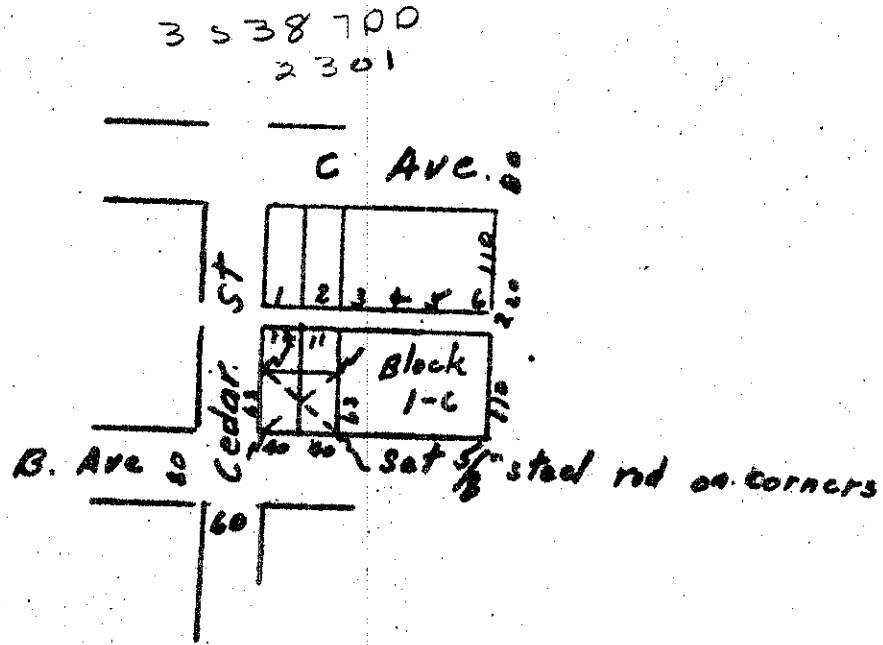


62-70

Edward H. Hosley
201 Cedar Street
La Grande, Oregon.

Description
The south 63 feet of Lots 11 and 12 of Block 1-C of the Original town of LeGrand (La Grande) Oregon according to recorded plat on record at Union County Court House at La Grande, Oregon.

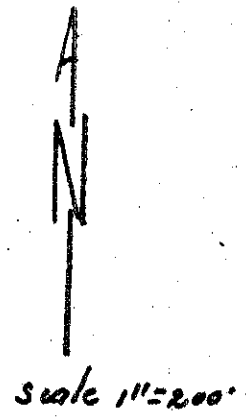

REGISTERED
OREGON
LAND SURVEYOR
James G. Voelz
MAY 4, 1936
JAMES G. VOELZ
381

62-70