


70-70

Bruce Ausmus
701 Crook Ave.
La Grande, Oregon

Oct. 28, 1970

Description:
The east 50 feet of lots 14, 15 and 16 of Block 19 of Riverside Addition
to LaGrande, Oregon.

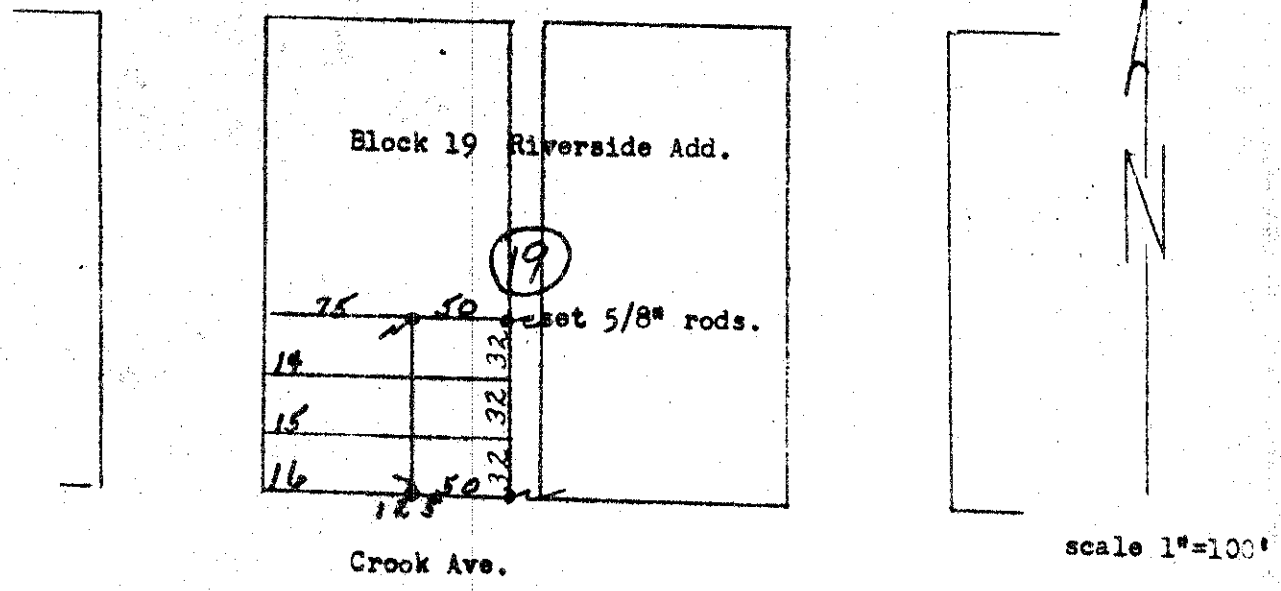

3S 386AA
6300

REGISTERED
OREGON
LAND SURVEYOR

James G. Voelz

MAY 4, 1958
JAMES G. VOELZ
381

70-70