


71-70

Floyd A. Knight
3001 No. 2nd.
La Grande, Oregon

Sept. 24, 1969

Description:
Lots 5,6,7 and 8 of Block 5 and Lot 4 of Block 12 of
Sterling's Addition to Island City, Oregon.

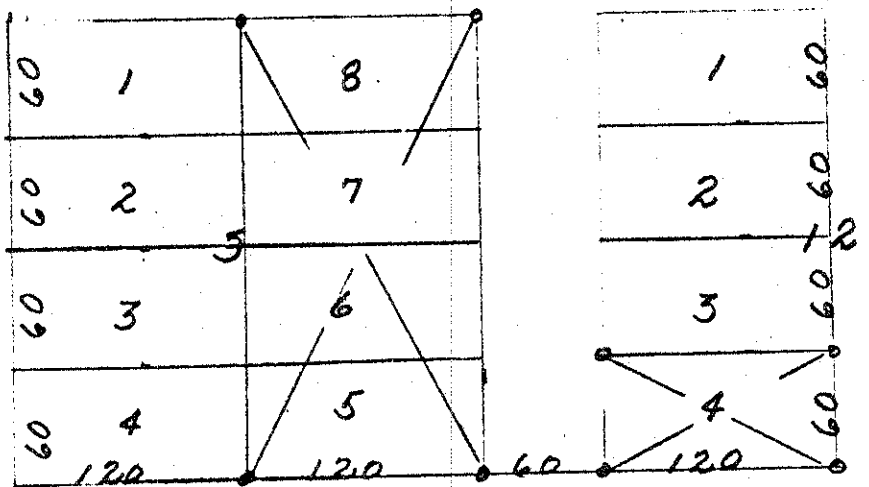

38323AB
1600
1601
1401

REGISTERED
 OREGON
 LAND SURVEYOR

James G. Voelz

MAY 4, 1966
 JAMES G. VOELZ
 331

71-70