


72-70

C. House

Richard Hermens .  
506- L Ave.  
La Grande, Oregon

Sept 14, 1970

3' 38" AC  
100  
101

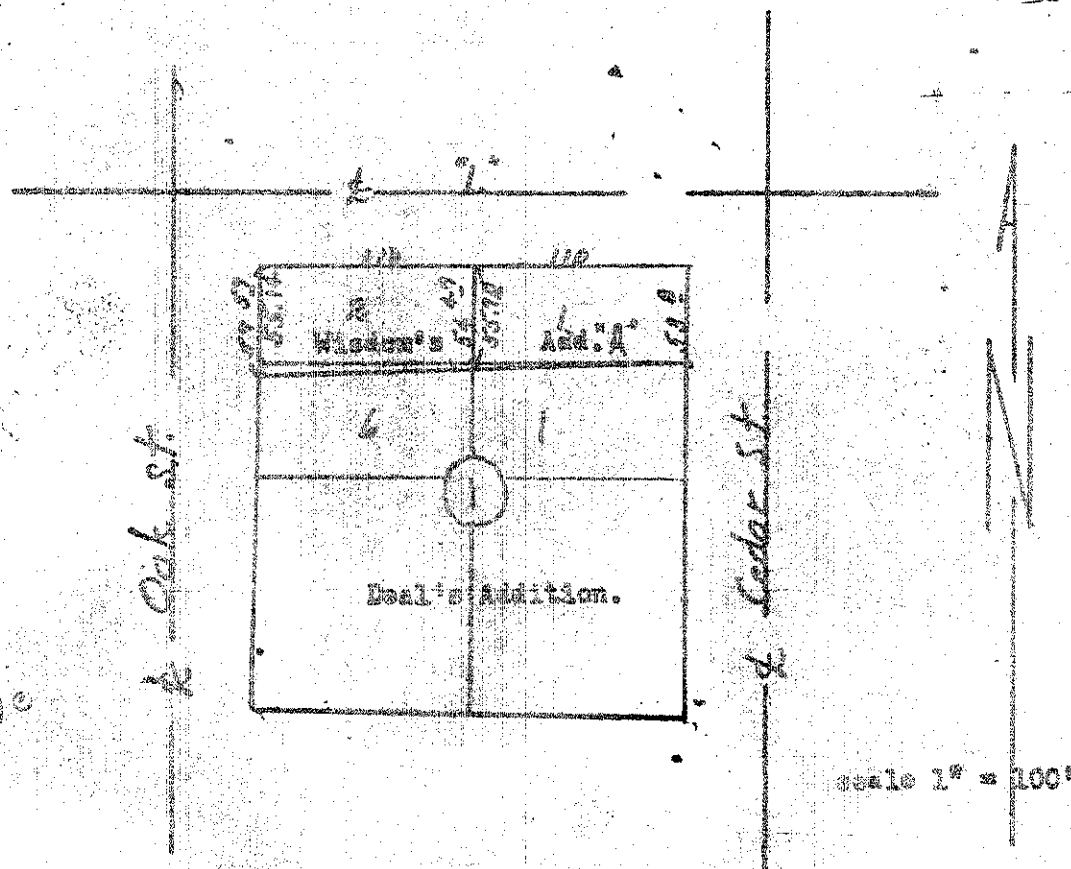

**Description:**  
All of Lots 1 and 2 of Block "A" of Wisdom's Addition, to LaGrande, Oregon.  
**ALSO:**

Beginning at the southeast corner of Lot 1 of Block "A" of Wisdom's Addition to La Grande, Oregon;  
Thence southwesterly to a point which is 2.43 feet south of southwest corner of Lot 2 Block "A" of Wisdom's Addition to La Grande. Said point also being the northwest corner of Lot 6 of Block 1 of Deal's Addition to La Grande, Oregon.  
Thence north 2.43 feet to the southwest corner of Lot 2 of Block A of Wisdom's Addition to La Grande.  
Thence easterly to point of beginning.

REGISTERED  
OREGON  
LAND SURVEYOR

*James G. Voelz*

MAY 4, 1953  
JAMES G. VOELZ  
361

72-70