


3-71

Manuel R. Gomes
525 Detroit St.
Elgin, Oregon.

Feb. 22, 1971

Description.
Lots 6 thru 12 of Block 19 of North Elgin Addition to Elgin, Oregon.

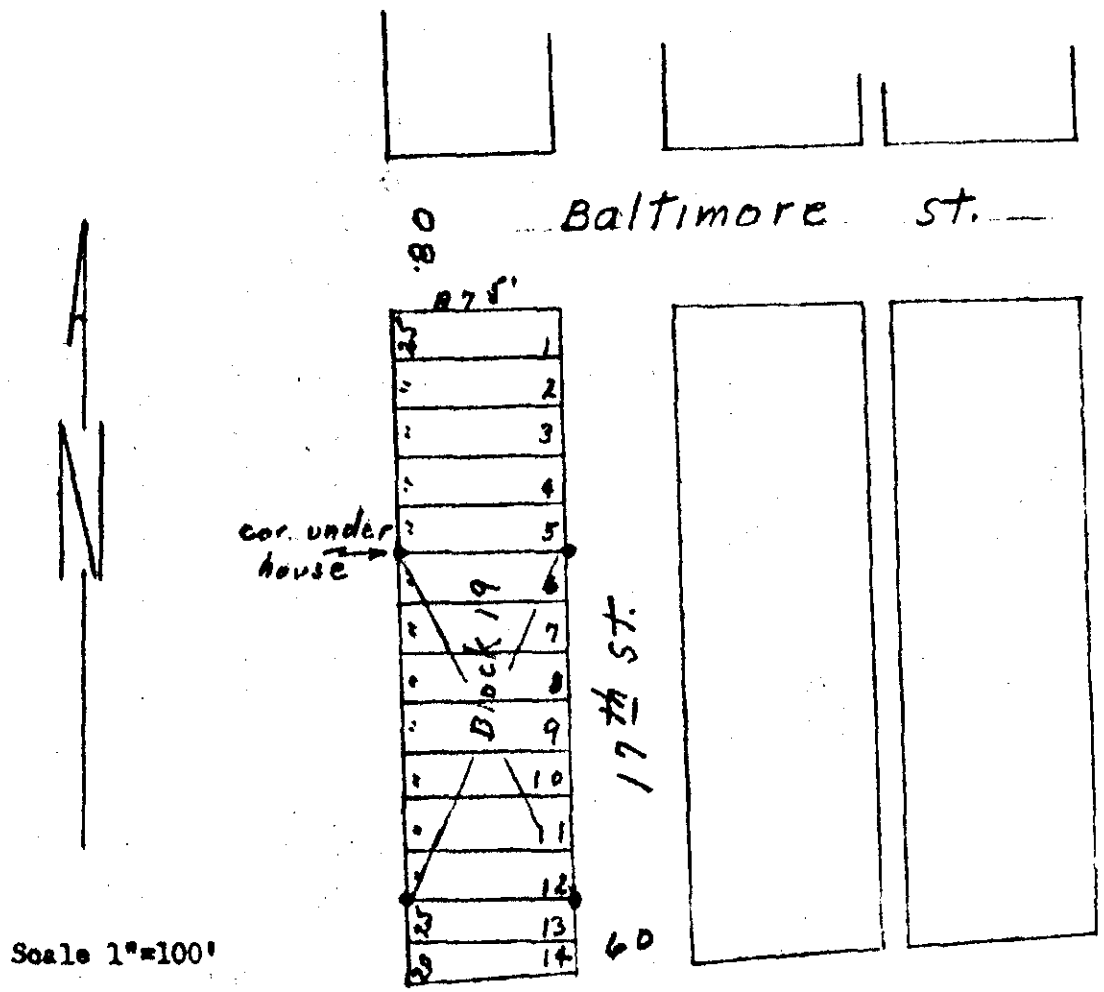

IN 39153D

REGISTERED
OREGON
LAND SURVEYOR

James G. Voelz

MAY 4, 1956
JAMES G. VOELZ
881

3-71