


6-71

Louie T & Verniece E. Gronde
820 Second St.
North Powder, Oregon

March 15, 1971

Scale 1"=100'

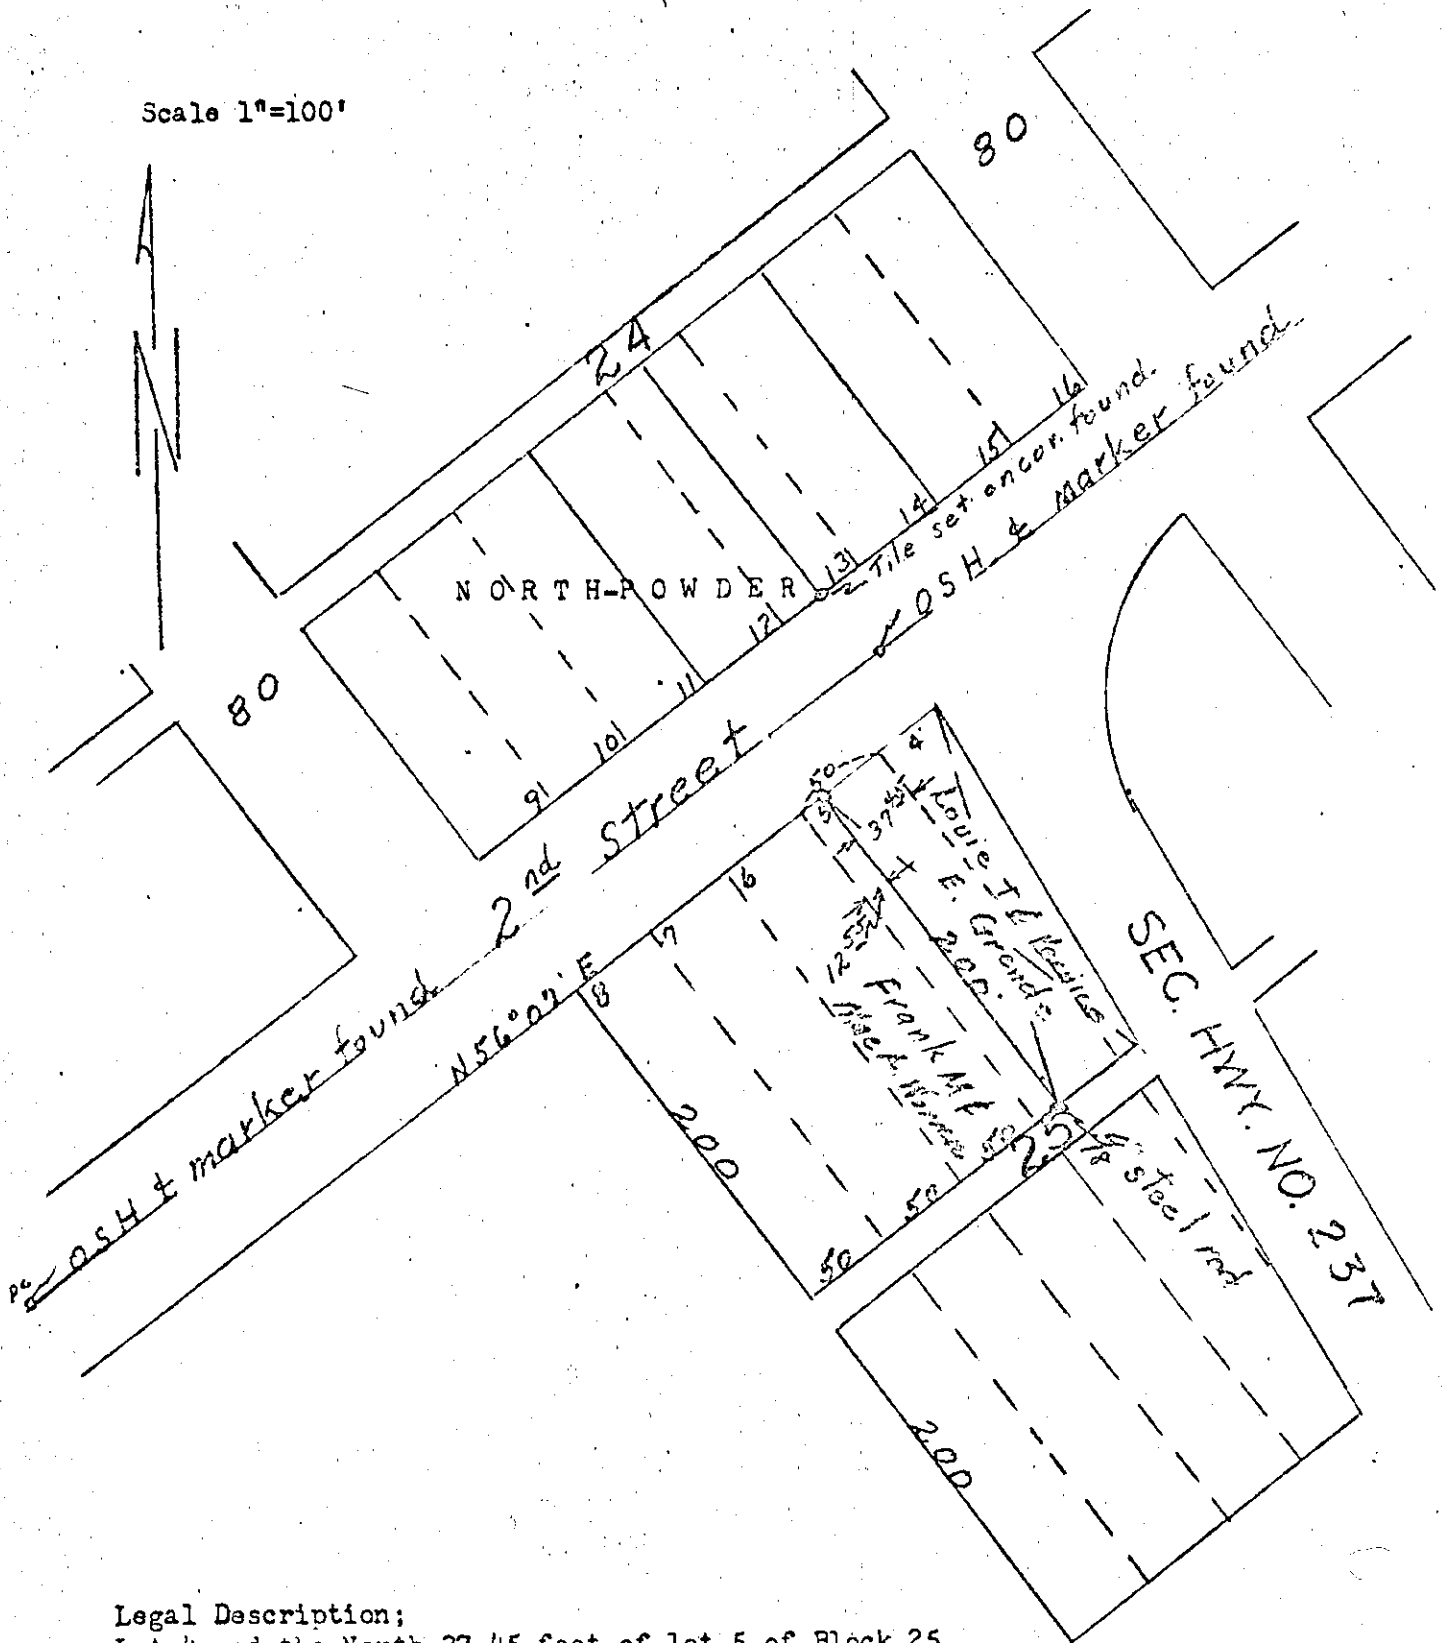

Legal Description;
 Lot 4 and the North 37.45 feet of lot 5 of Block 25
 of North Powder at North Powder, Oregon.
 Excepting that portion of lot 4 that is in Secondary Highway of State of Oregon
 numbered 237.

REGISTERED
 OREGON
 LAND SURVEYOR

James G. Voeltz

MAY 4, 1958
 JAMES G. VOELTZ
 331