


7-71


Vernon N Lund
540 Cedar
Elgin, Oregon

March 9, 1971

Legal description;
Lots 5 and 6 and north 12½ feet of lot 7 of Block 37 of Hindman's
Addition to Elgin, Oregon.

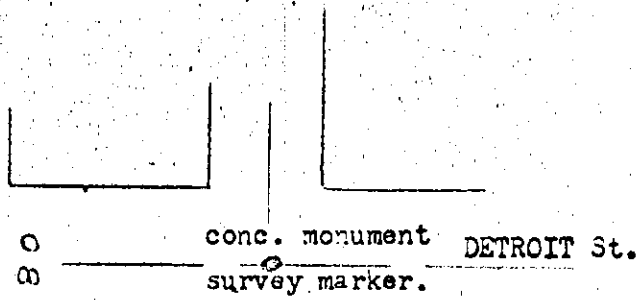

IN 39 15AC

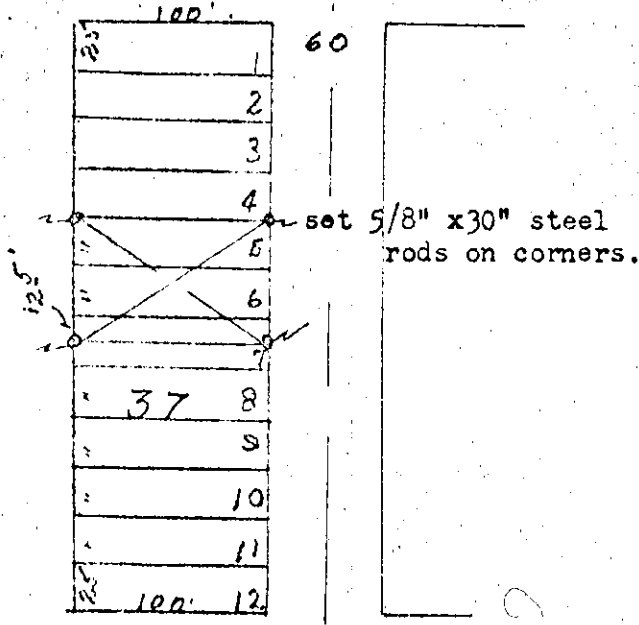

Scale 1" = 100'

REGISTERED
OREGON
LAND SURVEYOR

James G. Voelz

MAY 4, 1956
JAMES G. VOELZ
331