


9-71
C-11

Church of Nazarene
% Willis Baker
Island City.

March 8, 1971

33386DA

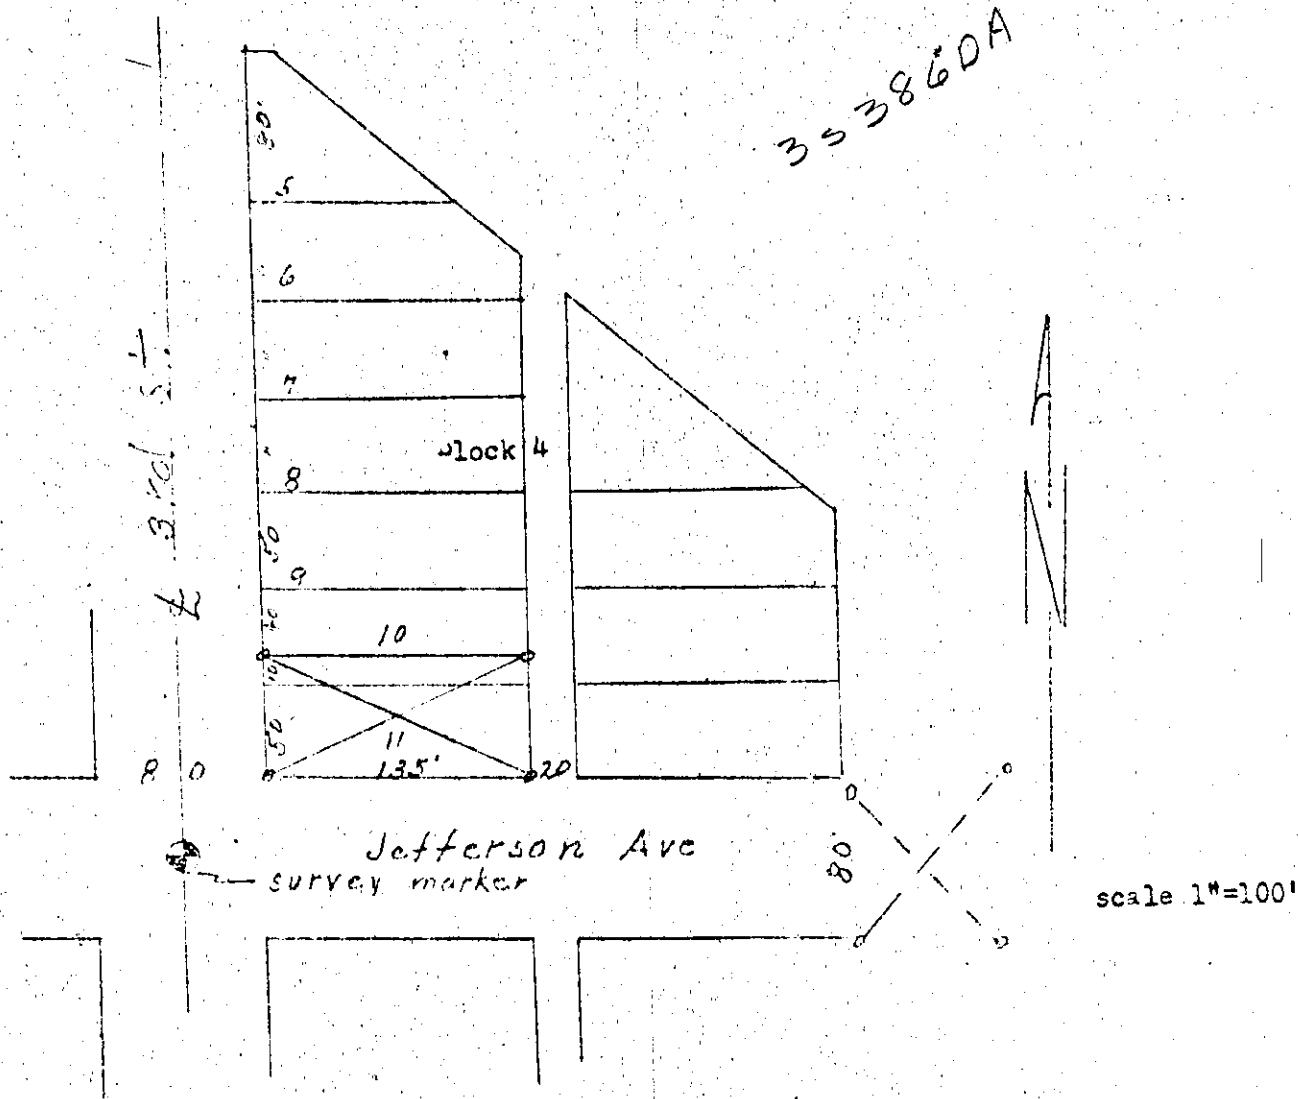

Legal description;
Lot 11 and south 10 feet of lot 10 of Block 4 of Grandy's Addition
to La Grande, Oregon.

REGISTERED
OREGON
LAND SURVEYOR

James G. Voelz
MAY 4, 1953
JAMES G. VOELZ
331