
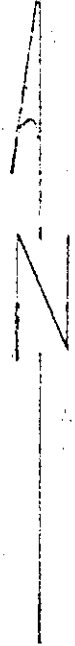


11-71

Bob Fallows

Jan. 19, 1971

Description;
Lots 7 through 14 of block 117 of Chaplins Addition to La Grande, Oregon.

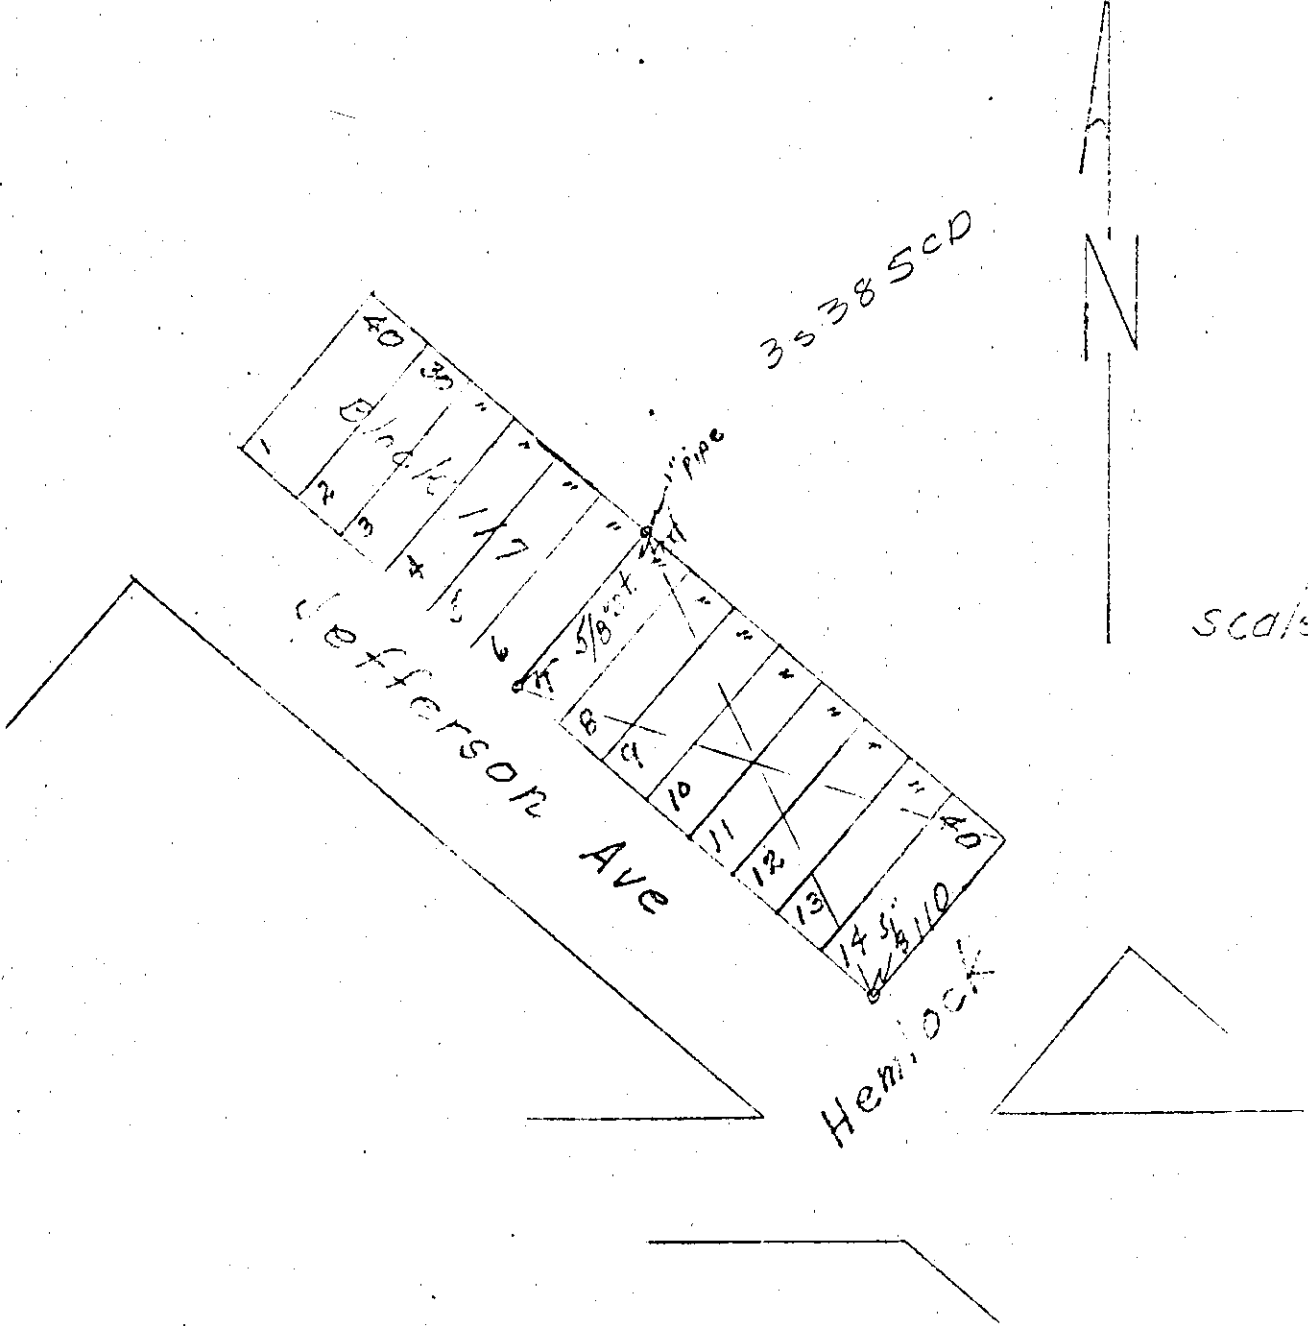

Scale 1" = 100'

REGISTERED
OREGON
 LAND SURVEYOR

James G. Voelz
 MAY 4, 1953
JAMES G. VOELZ
 381