


17-71

2

Larry Starr
Summerville, Oregon

April 2, 1971

Description;
NW $\frac{1}{4}$ NE $\frac{1}{4}$ Section 35, T1N. R38EWM

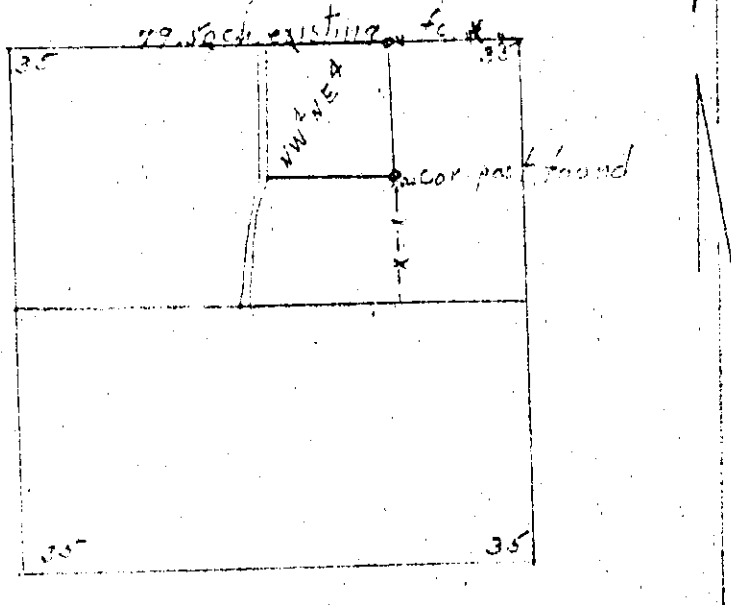

Scale 1"=2000'