
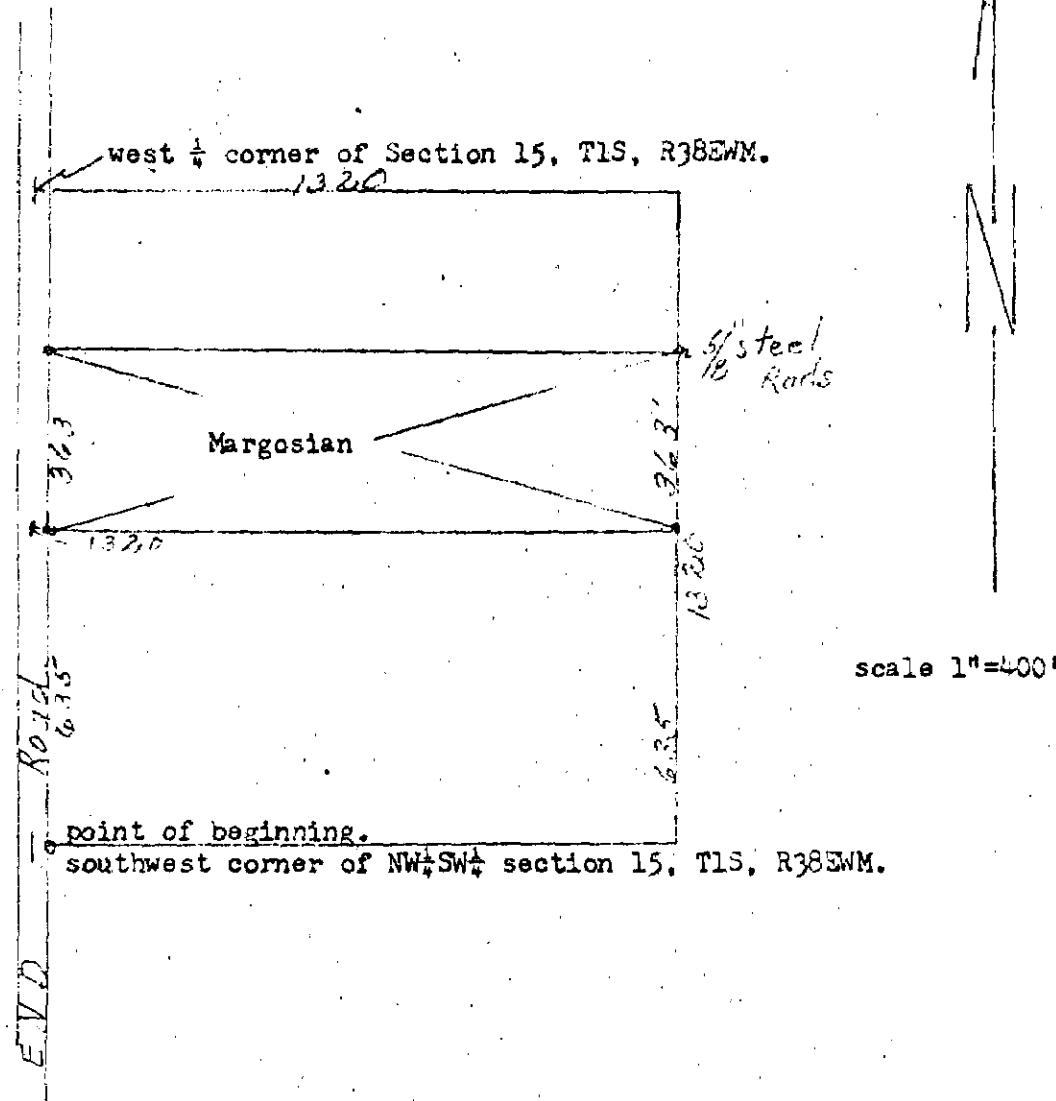


Richard Margosian  
2107 first st.  
La Grande, Oregon

April 3, 1971

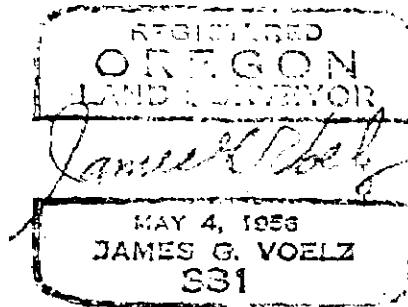

Description:

Beginning at a point on west boundary of NW $\frac{1}{4}$ SW $\frac{1}{4}$  of Section 15, T1S, R38EWM said point being 635 feet north of southwest corner of said NW $\frac{1}{4}$ SW $\frac{1}{4}$ . thence north 363 feet; thence east to east boundary of NW $\frac{1}{4}$ SW $\frac{1}{4}$  said section 15; thence south 363 feet; thence west 635 feet to point of beginning. SITUATE in NW $\frac{1}{4}$ SW $\frac{1}{4}$  of Section 15, T1S, R38EWM. and containing 11.0 Acres and subject to road right of way on the west side.