


19-71

R.L. Schultz
275 S. Bellwood
Union, Oregon

April 12, 1971

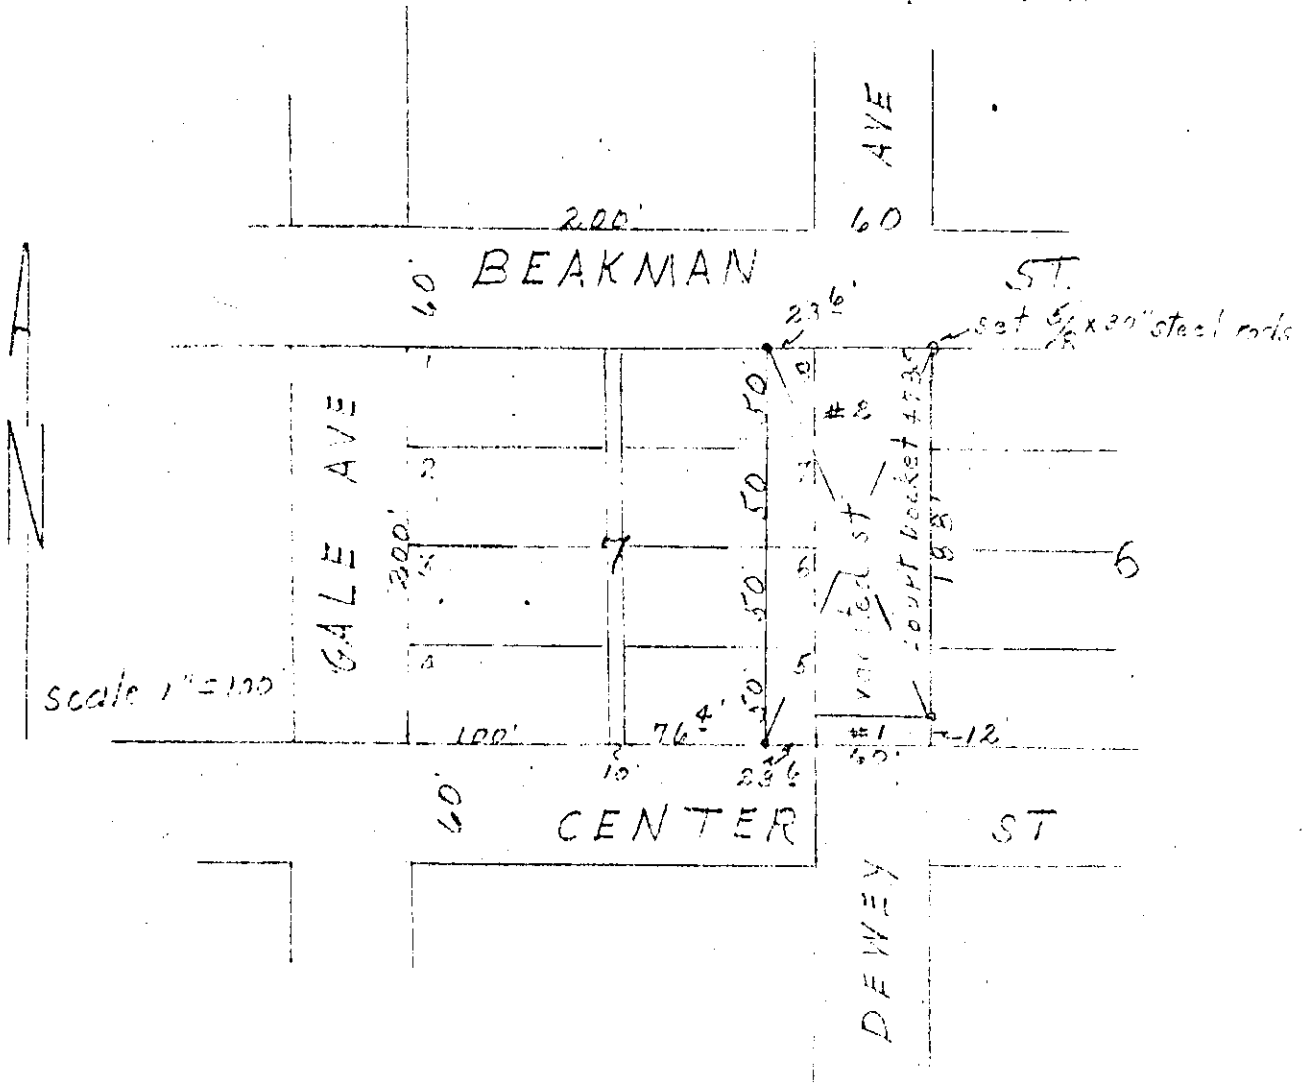

Description;

#1 The south 12 feet of vacated Dewey Ave. between Blocks six and seven in Town of Union, according to the recorded plat of said Town. SITUATED IN Union, Oregon.

#2. The east 23.6 feet of Block 7 in the Town of Union, according to the recorded plat of said Town.

ALSO:

The north 188 feet of vacated Dewey Ave. Between Blocks six and seven in the Town of Union, according to the recorded plat of said Town. SITUATED IN Union, Oregon.

REGISTERED
 OREGON
 LAND SURVEYOR
James G. Voelz
 MAY 4, 1963
 JAMES G. VOELZ
 301