


Found brass tablet in concrete block, 28\"/>

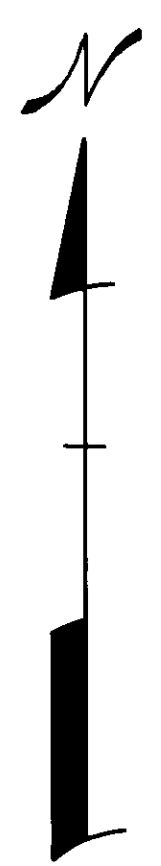

BASIS of BEARING
 Forward Bearing as published by the
 U.S.C. and G.S. from Δ College
 to Δ Valley

LEGEND

- Found monument of record
- ⊙ Found Govt. survey monument of record.
- Found unrecorded, 5/8" iron pin, by Voelz.
- ⊙ Set 2" x 30" iron pipe.
- Set 5/8" x 30" iron pin with plastic cap mkd. "B G F survey mk."
- () Record bearing and distance

REGISTERED
OREGON
 LAND SURVEYOR

Duane I. Griffith
 JULY 10, 1964
 DUANE I. GRIFFITH
 644

BAGETT-GRIFFITH-FERGUSON		
LaGrande, Oregon		
Map of Survey		
Portion of Sections 8&17,		
T 3 S, R 38 E, W.M.		
LaGrande		
Union County, Oregon		
SURVEYED FOR	SUNNY HILL ACRES Inc.	
SURVEYED BY	D.I.G.	Apr. 1971
Scale: 1" = 100'	Drawn by: D.I.G.	Apr. 1971

Survey no 12-69