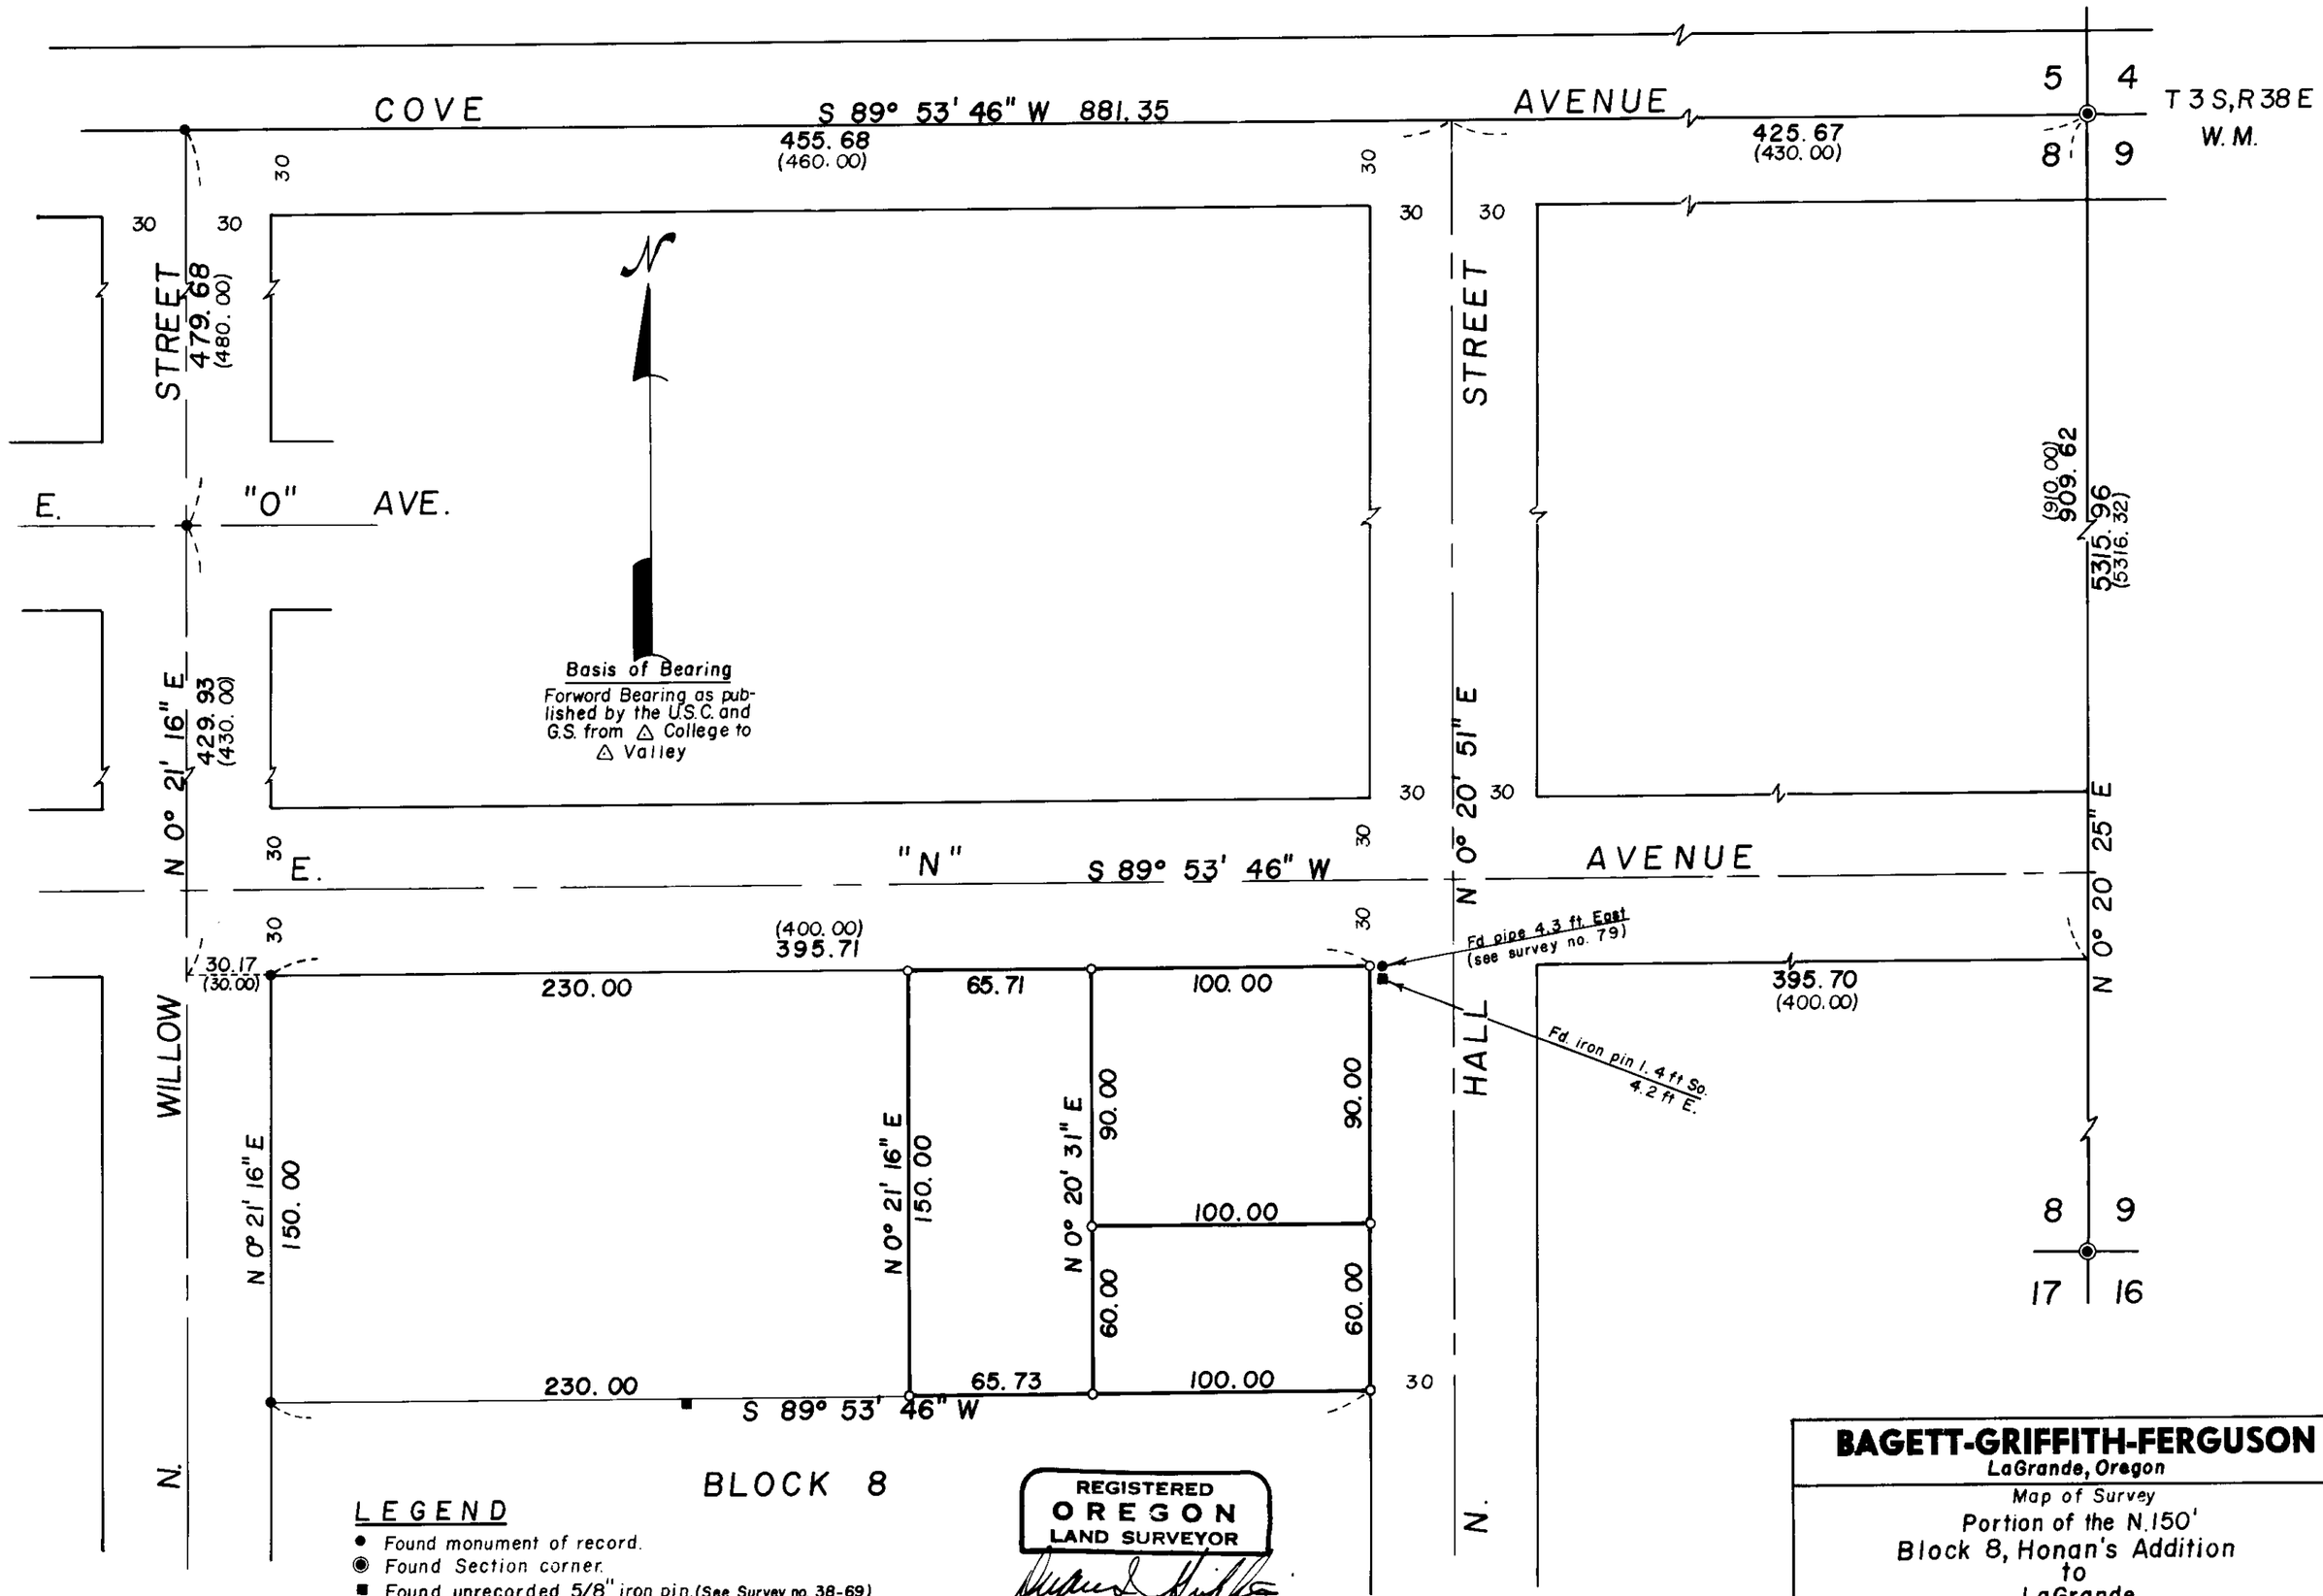

LEGEND

- ● Found monument of record.
- ◉ Found Section corner.
- ■ Found unrecorded 5/8" iron pin. (See Survey no. 38-69)
- ○ Set 5/8" 30" iron pin, with plastic cap mkd "BGF survey mk"
- ( ) Record bearing and distance

BAGETT-GRIFFITH-FERGUSON
LaGrande, Oregon

Map of Survey
Portion of the N.150'
Block 8, Honan's Addition
to
LaGrande
Union County, Oregon

SURVEYED FOR	GLENN LESTER	
SURVEYED BY	D.I.G	Apr 1971
Scale: 1" = 50'	Drawn by: D.I.G.	May 1971