


City of North Powder  
North Powder, Oregon.

May 1, 1971

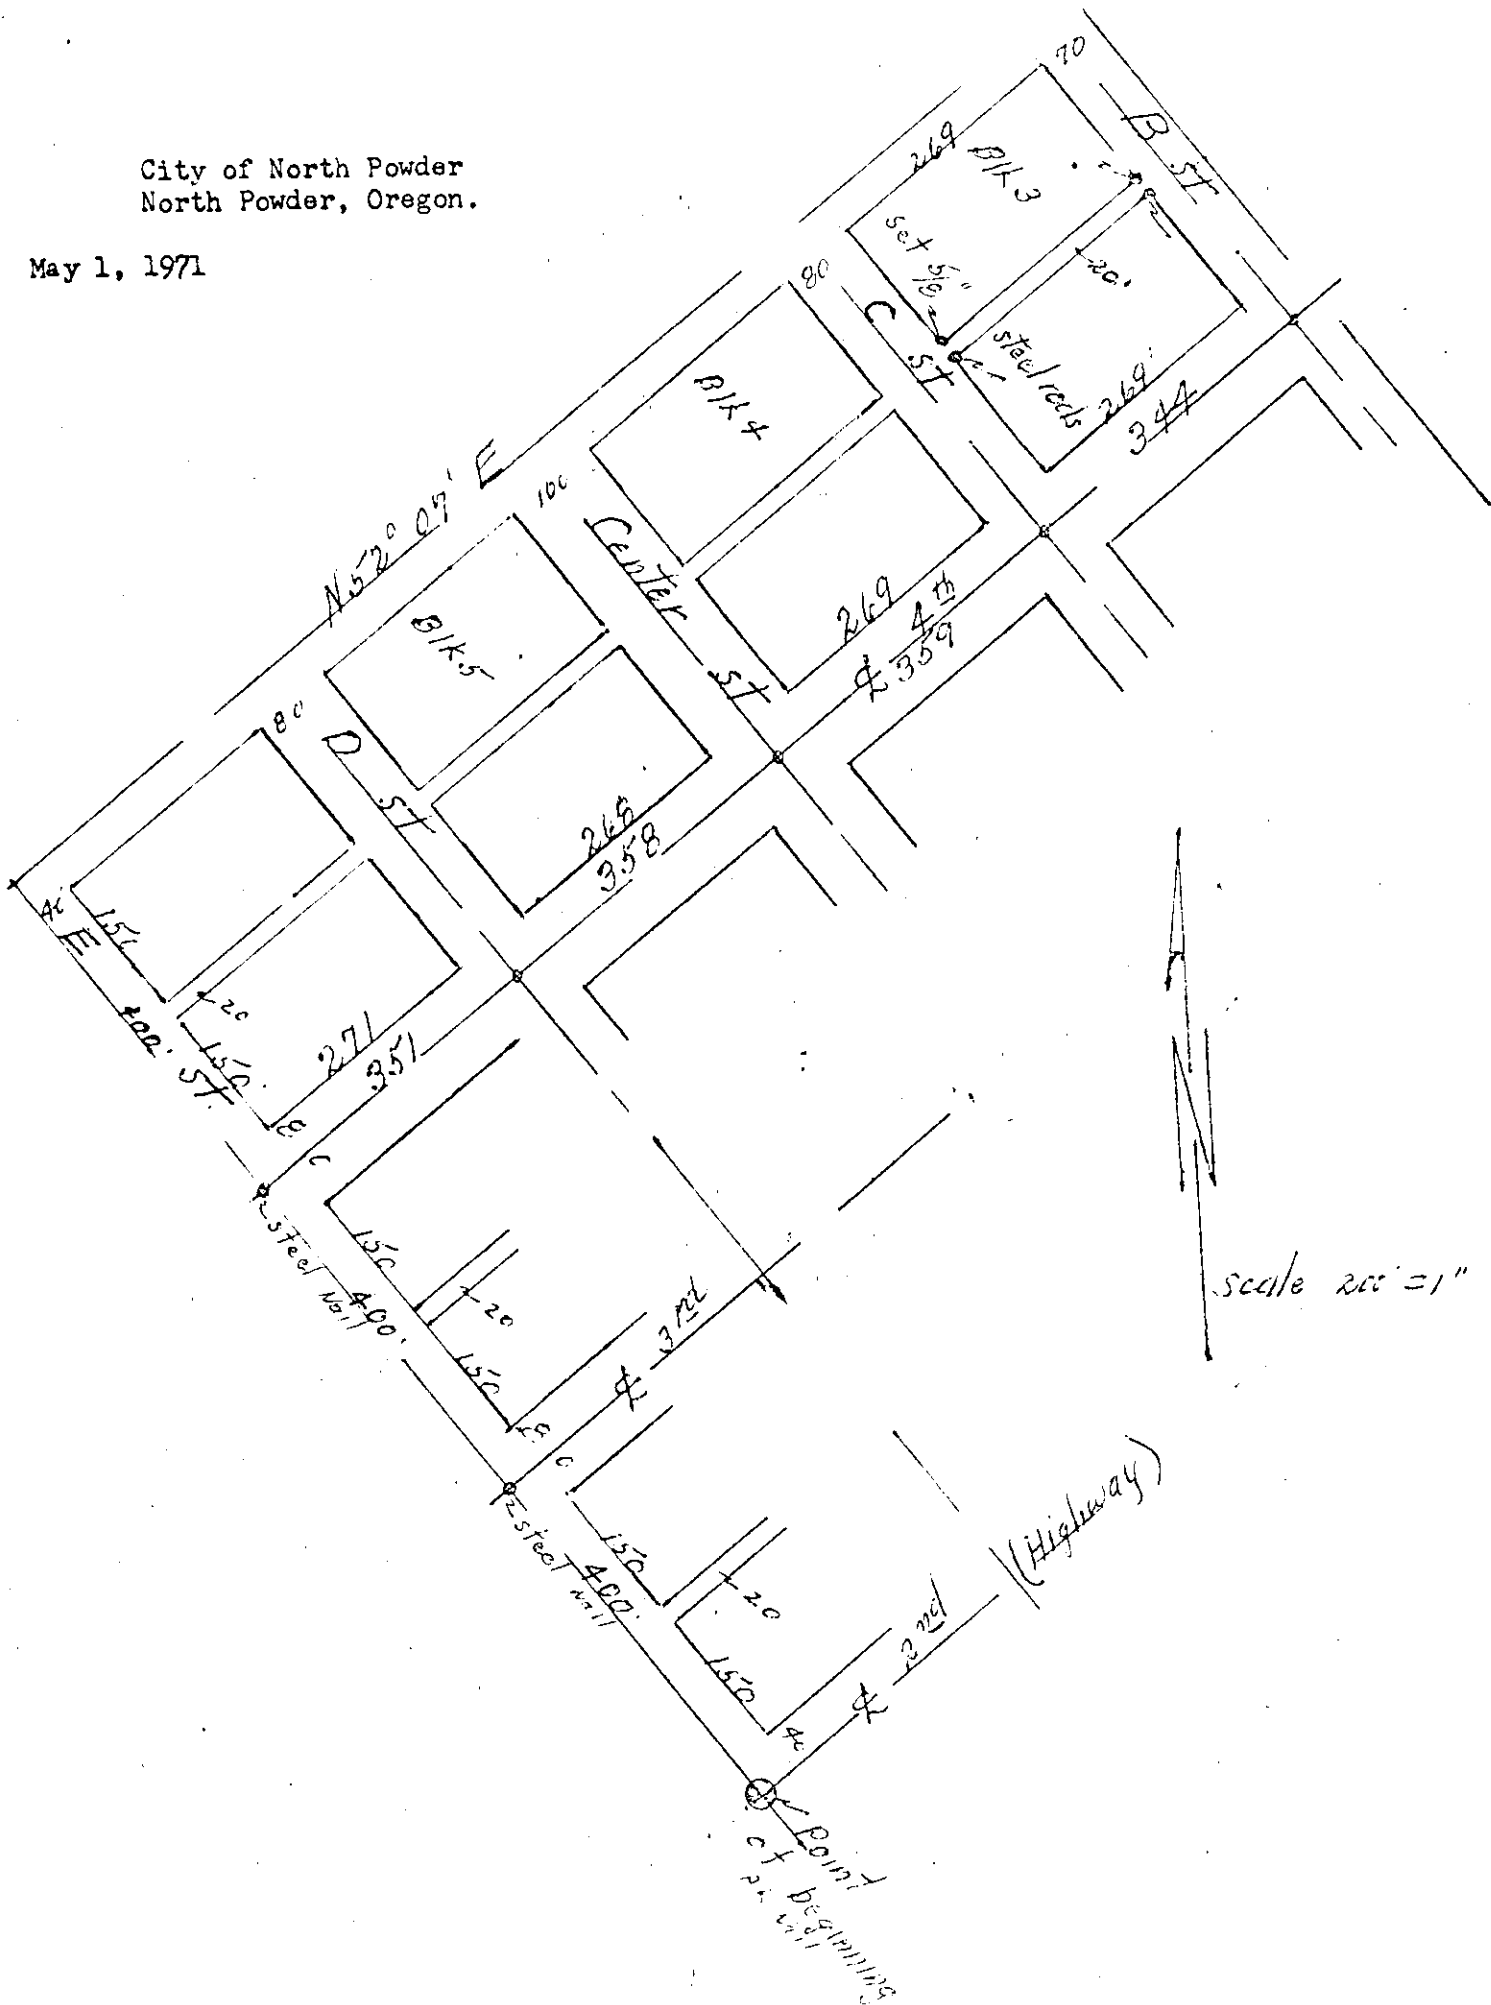

scale 200' = 1"

Establish the four corners of the alley through Block 3 of North Powder.

REGISTERED  
OREGON  
LAND SURVEYOR

*James G. Voelz*

MAY 4, 1953  
JAMES G. VOELZ  
331