

27-71


Mr. Robbins  
1608 Oak St.  
La Grande, Oregon

May 4, 1971

Description;  
lot 10 of Block 9 of Romig's Addition to La Grande, Oregon.



scale 1" = 100'

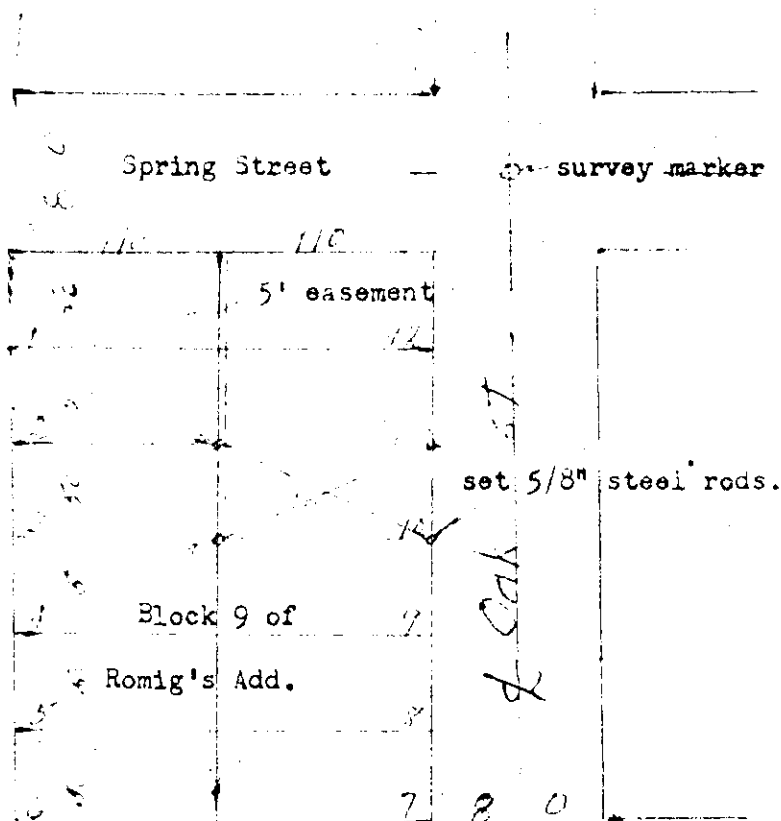

REGISTERED  
OREGON  
LAND SURVEYOR

*James G. Voelle*

MAY 4, 1971  
JAMES G. VOELLE  
331