


CERTIFIED RECORD OF LAND CORNER MONUMENTATION

History of original corner establishment:

Original Survey by General Land Office;
(contract survey 1863)

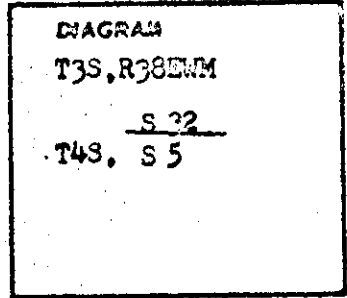

The original notes read;
At 40.00 ch. set post from which;
A pine 8" in diam bears N55°W 72 lks dist.
A spruce 6" in diam bears S5°W 38 lks. dist.


Description of corner evidence found:

A slab from the pine bearing tree was found with the "BT" scribe visible.
No other positive evidence was found at the corner. Evidence of the old fences were found that are now almost completely rotted away.

Description of monument and accessories established to perpetuate the original location of this corner

At the position of the corner I set a 30" galvanized pipe with a bronze cap on top and an eight inch plate welded to the bottom. The pipe was set to a depth of approx. 20" and back filled with stone and tamped earth.

I stamped the disk. →

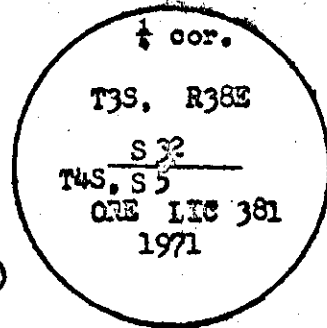

From the monument the original bearing trees were -(none)
Two new bearing trees were established.
A douglas fir 12" in diam bears N9°W a dist. of 11.2 ft.
scribed 1/8 BT; A white fir 7" in diam bears S36°E a dist of 5.1 ft.
scribed 1/8 BT. The distance measured to center of the respective trees.

REGISTERED
OREGON
LAND SURVEYOR

James G. Voelt

MAY 4 1971
JAMES G. VOELT
381

Office of County Surveyor County of Union State of Oregon
I hereby certify that the within instrument was filed in this office
for record on the 12 day of July 1971 at 8 o'clock A.M. (P.M.)
County Surveyor by *James G. Voelt*
(COUNTY OFFICIAL) (DEPUTY)

46-1971