
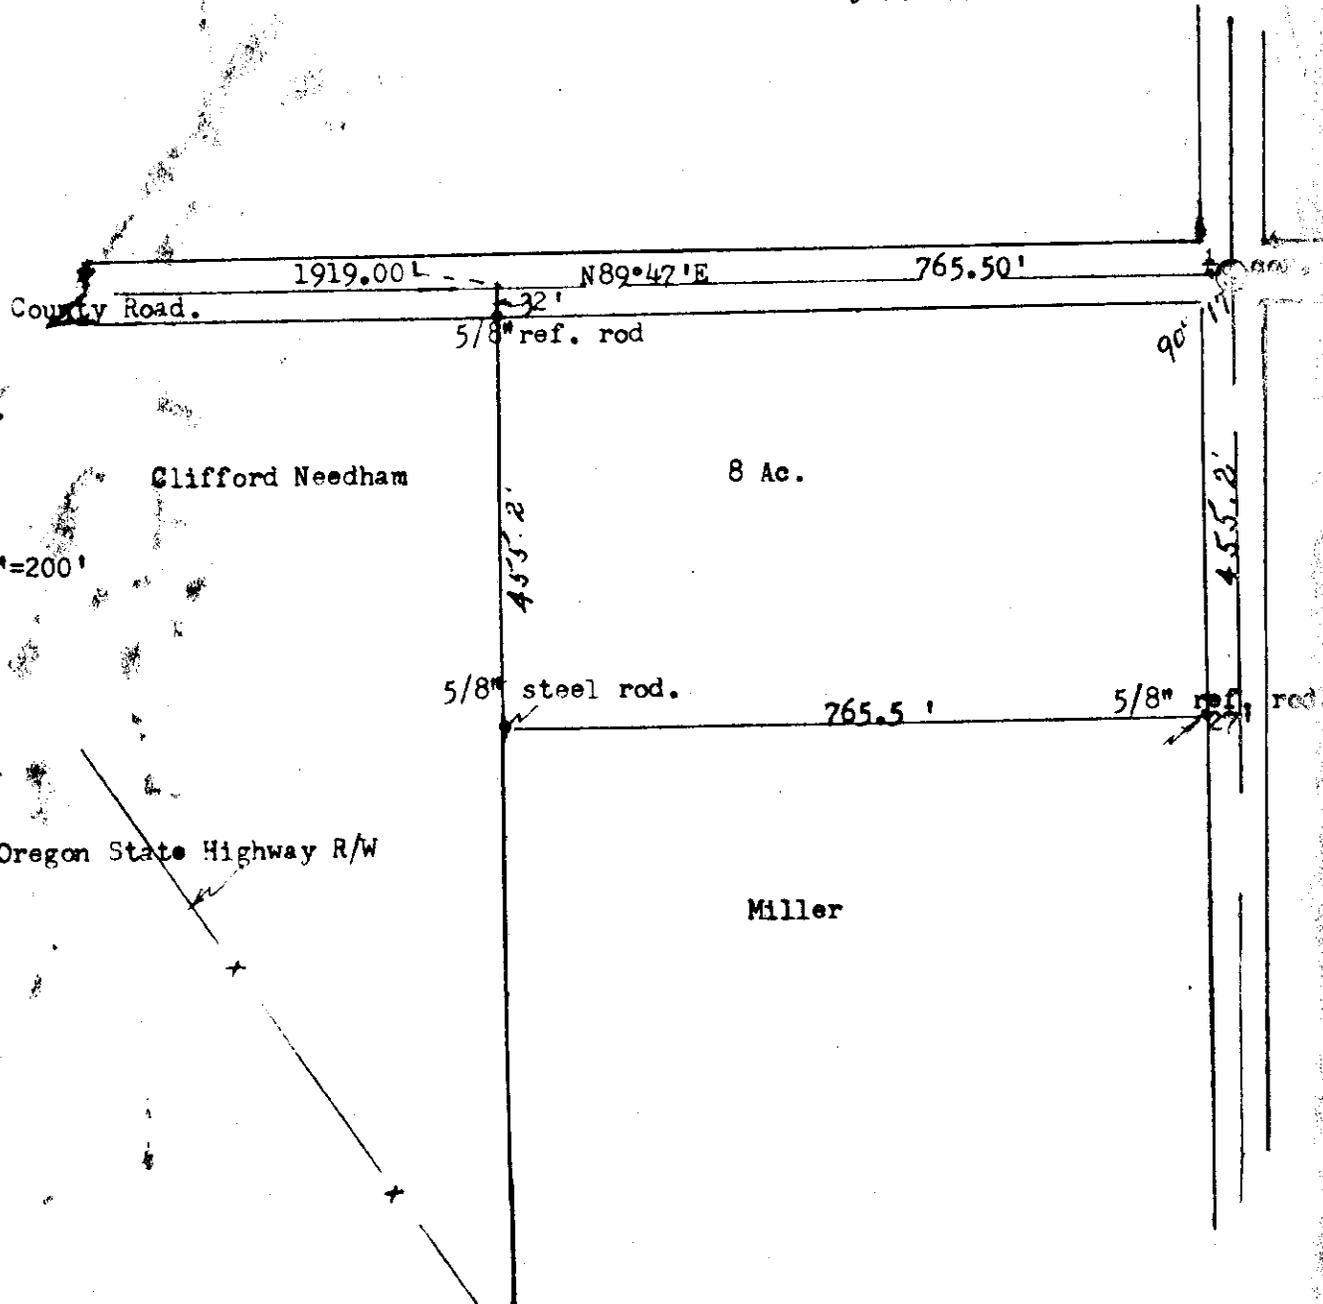


E. Miller  
Gekeler Lane  
La Grande, Oregon.

July 7, 1971

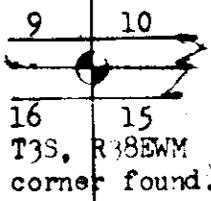

scale 1"=200'

Oregon State Highway R/W

Miller

Legal Description;  
The north 455.2 feet of the east 765.5 feet of NE1/4NW1/4 of Section 15, T3S, R38EWM.  
SUBJECT TO: Road right of way on the north and east sides.

REGISTERED  
OREGON  
LAND  
*James J. Miller*  
JAMES J. MILLER

48-1971