


CERTIFIED RECORD OF LAND CORNER MONUMENTATION

History of original corner establishment:

Corner established in 1884 by General Land Office
(Contract survey)

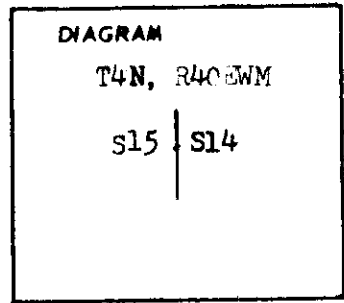

Original survey notes state;

Set a post at the corner from which;

A fir 8" in diameter bears S70°W a distance of 5- lks
marked $\frac{1}{4}$ SBT

A fir 10" in diameter bears N50°E a distance 10 lks.
marked $\frac{1}{4}$ SBT.


Description of corner evidence found:

At recorded distance from the corner I found a 19" fir snag with scribe.
There was not any evidence of the other bearing tree.

Description of monument and accessories I established to perpetuate the
original location of this corner

At the position of the corner I placed a galvanized pipe 30" long with an eight
inch plate welded to the bottom and bronze cap on top of the pipe. The pipe
was set to a depth of 24" and back filled with tamped earth.

I stamped the disk →

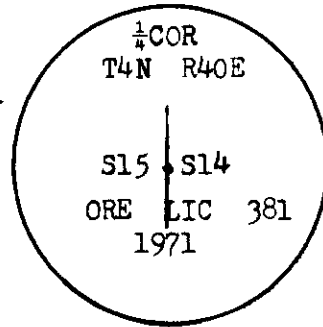

From the corner the original bearing tree is;

A 19" fir snag at N50°E a distance of 10 lks.

I established two new bearing trees;

A Red Fir 16" in diam. bears S80°W a distance of 45.7 feet measured to center of
tree and scribed $\frac{1}{4}$ SBT; A spruce 16" in diam. bears S44°E a distance of 9 feet measured
to center of tree and scribed $\frac{1}{4}$ SBT;

I placed a treated wood post by the corner with USFS sign 54-4 attached. USFS bearing
tree signs were placed on the three trees breast high facing the corner.

Office of.....County Surveyor..... County of.....Union.....
 State of Oregon....., I hereby certify that the within instrument was filed in this office
 for record on the 19 day of June..... 1971, at 8 o'clock a.m., (signed)

 County surveyor by James G. Vohle
 (COUNTY OFFICIAL) (DEPUTY)

RECORDED
 MAY 6 1971
 JAMES G. VOHLE
 COUNTY CLERK

52-1971