

CERTIFIED RECORD OF LAND CORNER MONUMENTATION

History of original corner establishment:

Corner established in 1834 by General Land Office  
( contract survey)

Original survey notes read;


A tamarack tree for the corner from which;

A tamarack 18" in diam bears N50°W 23 lks dist marked  
T4N R40E S19BT;

A tamarack 20" in diam bears N35°E 12 lks dist. marked  
T4N R40E S20BT;

A tamarack 20" in diam bears S47°E 17 lks dist marked  
T4N R40E S29BT;

A tamarack 12" in diam bears S55°W 40 lks dist marked T4N R40E S30BT;

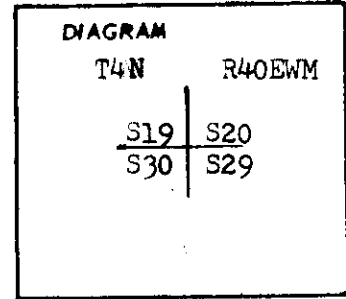

Description of corner evidence found:

At the corner we found four down tamarack trees.

At N50°W a tamarack log with full scribe. The stump of the tree still in place.

At N35°E a tamarack log down with scribe.


At S47°E found a rotten log with partial scribe visible.

At S55°W found a rotten log with full scribe visible.

No evidence of the tree for the corner was found.

Description of monument and accessories I established to perpetuate the original location of this corner

At the position of the corner I placed a galvanized iron pipe 30" long with an eight inch plate welded to bottom and a bronze cap on top. The pipe was set to a depth of 24 inches and back filled with tamped earth.

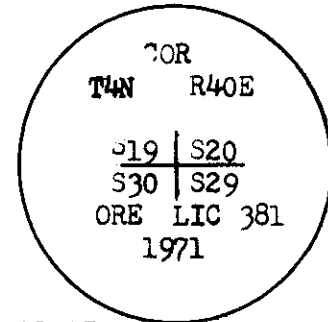

I stamped the disk →

From the monument the original bearing trees are; All trees were down so established four new bearing trees;

A white fir 9" in diam bears N30°W a distance of 7.8 ft.

scribed T4N R40E S19BT; A white fir 10" in diam bears N31°E a distance of 16.9 ft. scribed T4N R40E S20BT; A white fir

13" in diam bears S26°E a distance of 8.4 ft scribed T4N R40E S29BT;

A white fir 10" in diam bears S82°W a distance of 30.7 ft. scribed T4N R40E S30BT;

All distances are measured to center of respective trees. I placed a treated wood post near the corner with USFS sign 54-4 attached. I placed USFS bearing tree signs on the four down bearing trees and placed the sign on the new trees breast high facing the corner.

Office of..... County Surveyor..... County of..... Union.....  
State of Oregon....., I hereby certify that the within instrument was filed in this office  
for record on the 19 day of June..... 1971, at 8 o'clock a.m. (signed)  
..... County surveyor by James D. Boez (DEPUTY)  
(COUNTY OFFICIAL)

*James D. Boez*

54-1971