


CERTIFIED RECORD OF LAND CORNER MONUMENTATION

History of original corner establishment:

Corner established in 1884 by General Land Office.  
 (contract survey)  
 Original survey states: Set a post at the corner from which;  
 A spruce 30" in diameter, bears N5°W 9 lks distance marked  $\frac{1}{4}$ SBT;  
 A fir 13" in diameter bears S20°W 15 lks distance marked  $\frac{1}{4}$ SBT

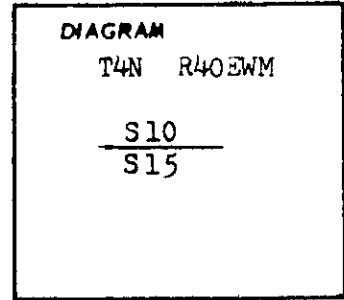


Description of corner evidence found:

At recorded distance from the corner I found a 38" fir with the scribe visible at N5°W at a distance of 9 lks. We could not find any trace of other bearing tree. The fir was called a spruce. This tree is very old and for this reason we established two new bearing trees.

Description of monument and accessories I established to perpetuate the original location of this corner

At the position of the corner I placed a galvanized pipe 30" long with a eight inch plate welded to bottom and a bronze cap on top. The pipe was set to a depth of 24" and back filled with tamped earth.

I stamped the disk →

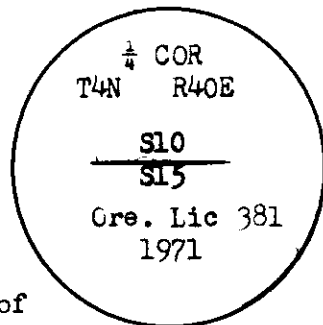

From the pipe monument the original bearing tree is.  
 A fir with scribe at N5°W at a dist. of 9 lks.  
 I also established two new bearing trees:  
 A fir 20" in diam. bears S69°E at a distance of 24.6 ft. measured to center of the tree and scribed  $\frac{1}{4}$ SBT;  
 A fir 42" in diam. bears S28°W at a distance of 25.7 ft. measured to center of tree and scribed  $\frac{1}{4}$ SBT;  
 I placed a treated post by the corner with USFS sign 54-4 attached.  
 USFS bearing tree signs were placed on the three trees breast high and facing the corner.

Office of.....County.....surveyor..... County of.....Union.....  
 State of.....Oregon....., I hereby certify that the within instrument was filed in this office  
 for record on the 16... day of June..... 1971, at 8... o'clock a.m., (signed)  
 County Surveyor..... by *Jamell Cook*  
 (COUNTY OFFICIAL) (DEPUTY)

RECEIVED  
 JAMELL COOK  
*Jamell Cook*  
 JUN 16 1971

55-1971