Maxine Grimes
2602 North 4th. Street
La Grande, Oregon

Aug 25, 1971

Scale 1"= 50'

Legal description:
All of lot 1 and the south 28 ft. of lot 2 of Block 6 of Riverside Addition to La Grande, Oregon.

set 5/8"X30" steel rod
( ) data of record
o corners of record on City survey map

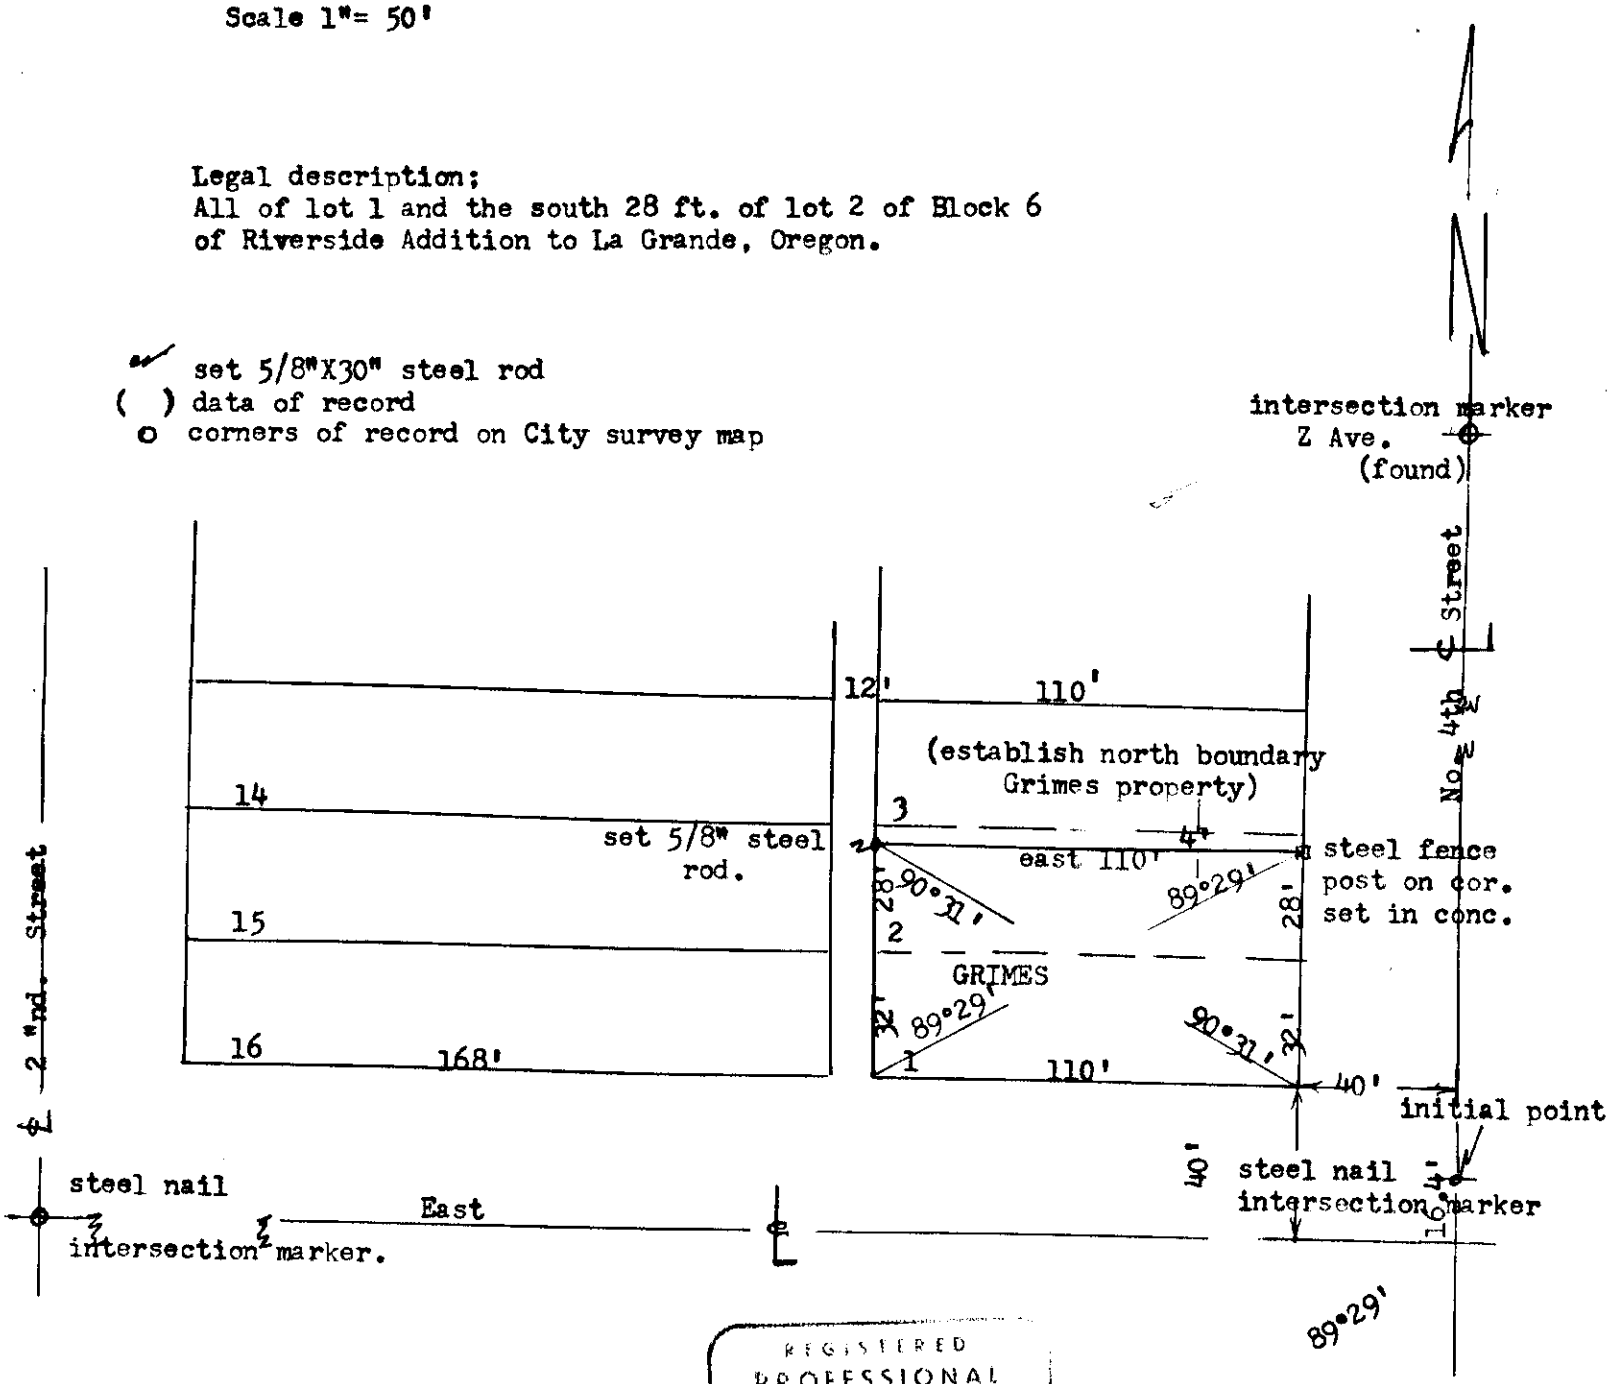

REGISTERED
PROFESSIONAL
LAND SURVEYOR
James G. Voelz
OREGON
MAY 4, 1956
JAMES G. VOELZ
381

59-71

59-1971