Ray White
Island City, Oregon

Aug. 15, 1971
~ set 5/8"x30" steel rod
( ) data of record.
- corners found
o 1" pipe
• 5/8" steel rod.

NW cor. of NE¼SW¼ of Sec. 3, T3S, R38EWM.
Rail road tie on corner.

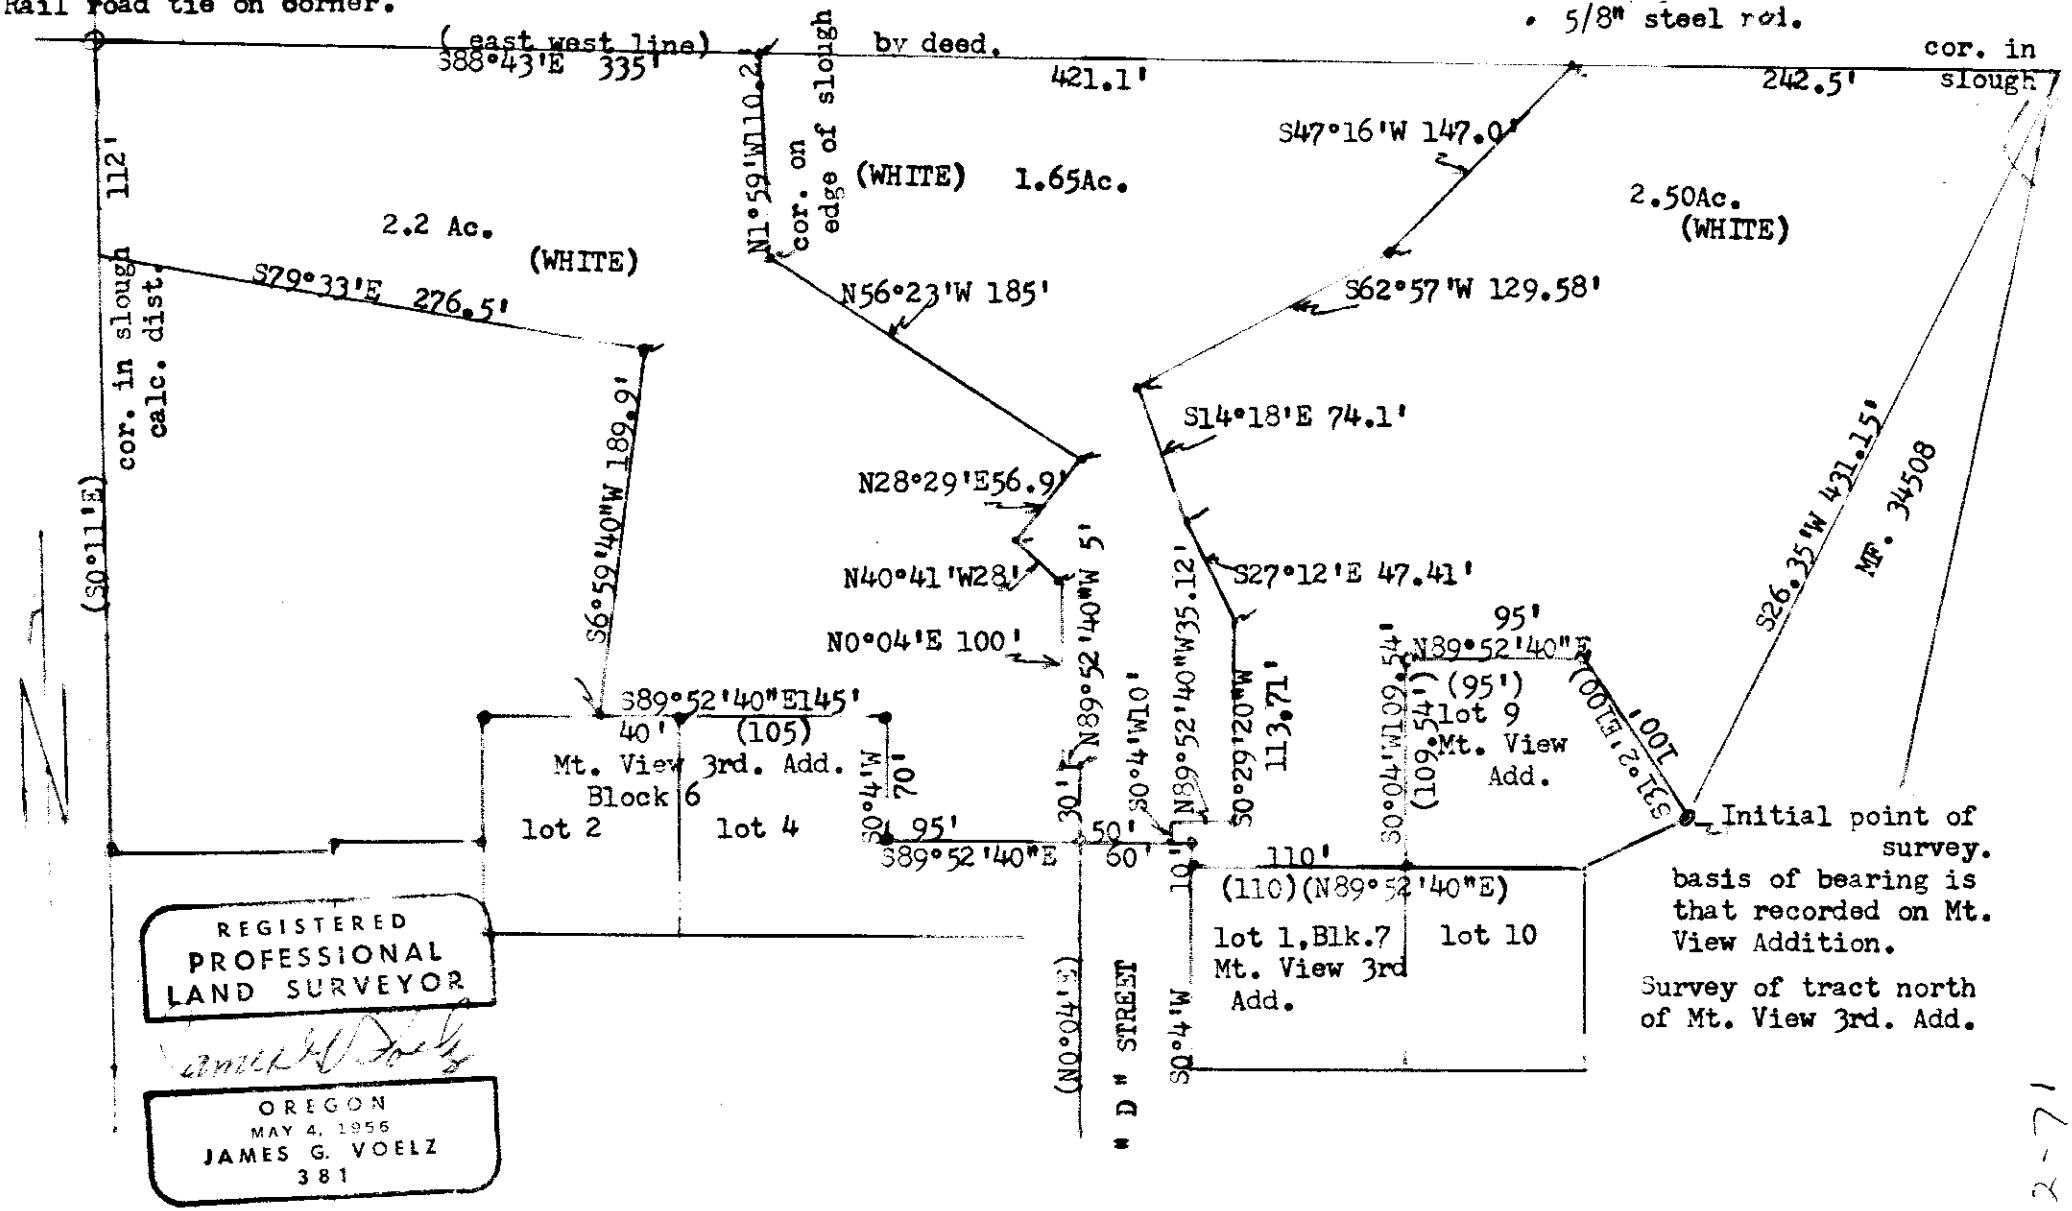

62-1971

62-71