


Marvin Gilikson
Union, Oregon

Sept. 1, 1971

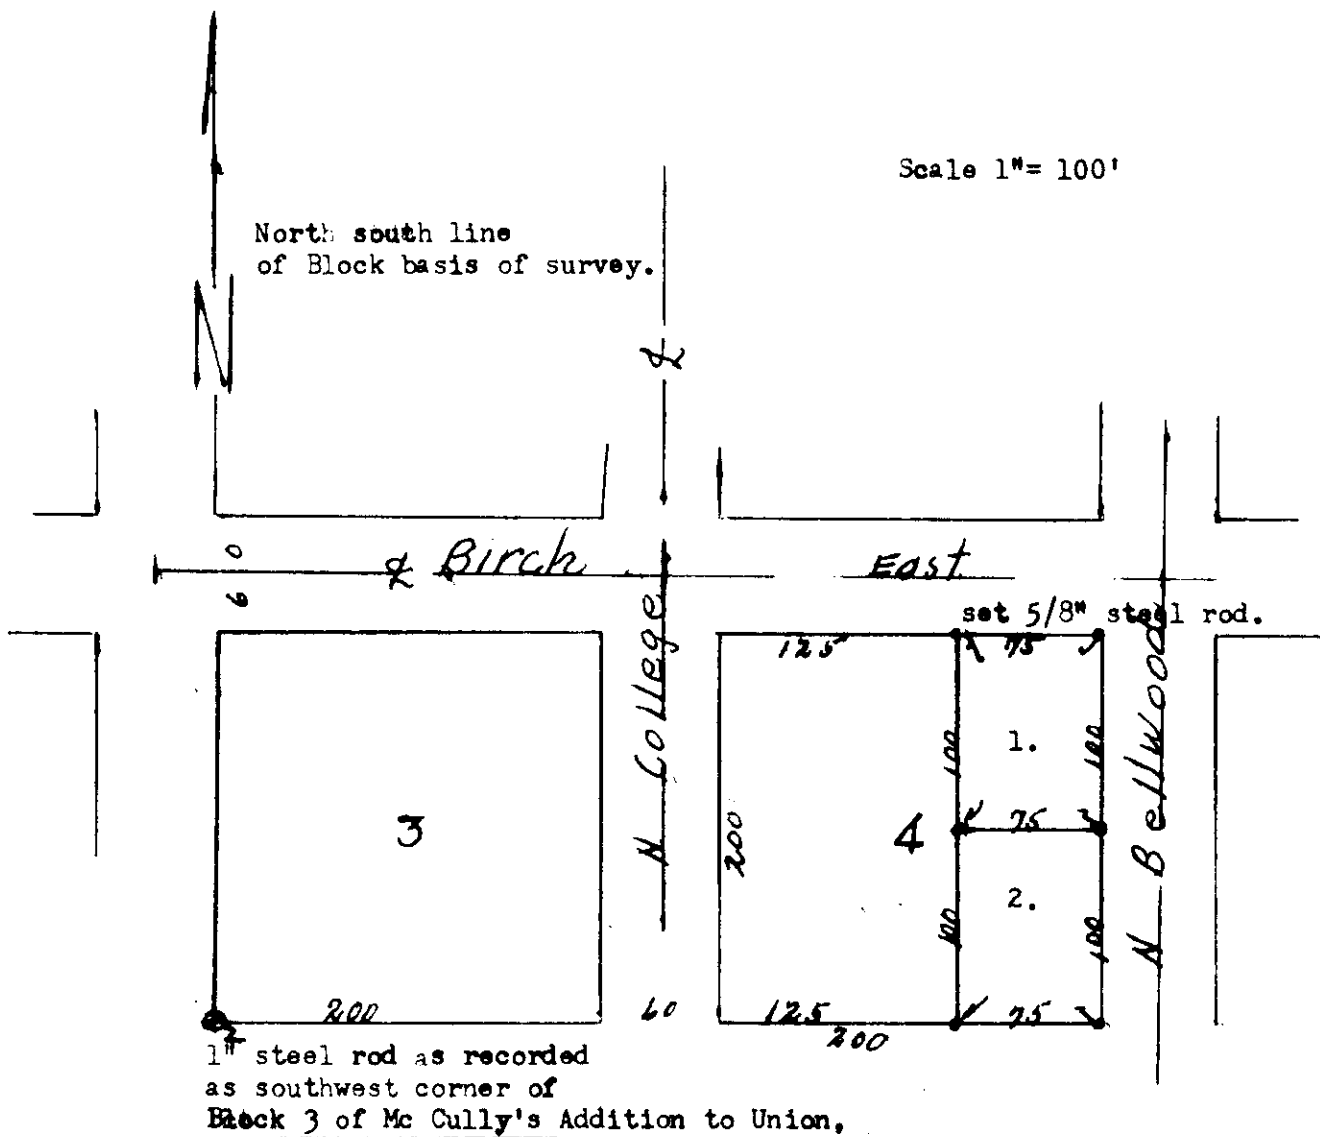

Description:

1. The east 75 ft. of the north 100 ft. of Block 4 of Mc Cully's Addition to Union, Oregon.
2. The east 75 ft. of the south 100 ft. of Block 4 of Mc Cully's Addition to Union, Oregon.

